


1 LOCATION OF WATER WELL: Pottawatomie
 County: Pottawatomie
 Fraction: SW 1/4 SE 1/4 SW 1/4
 Section Number: 3
 Township Number: 10
 Range Number: 10
 EW

Distance and direction from nearest town or city street address of well if located within city?
 600 Balderson, Wamego, Kansas

2 WATER WELL OWNER: Caterpillar Works Tools
 RR #, St. Address, Box #: 600 Balderson
 City, State, ZIP Code: Wamego, Ks 66547
 Board of Agriculture, Division of Water Resources
 Application Number:

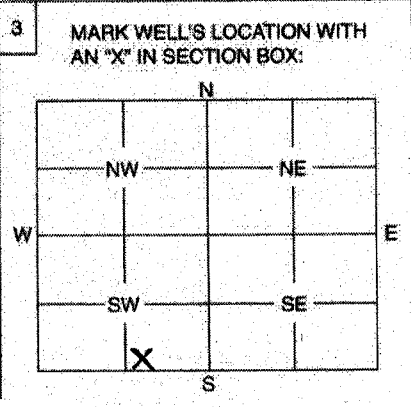

4 DEPTH OF WELL 37.5 ft.
 WELL'S STATIC WATER LEVEL 32.18 ft.
 WELL WAS USED AS:
 1 Domestic
 2 Irrigation
 3 Feedlot
 4 Industrial
 5 Public Water Supply
 6 Oil Field Water Supply
 7 Domestic (Lawn & Garden)
 8 Air Conditioning
 9 Dewatering
 10 Monitoring Well
 11 Injection Well
 12 Other.....
 Was a chemical / bacteriological sample submitted to Department? Yes No X.....
 If yes, mo/day/yr sample was submitted
 Water Well Disinfected: Yes No X.....

5 TYPE OF BLANK CASING USED:
 1 Steel
 2 PVC
 3 RMP (SR)
 4 ABS
 5 Wrought
 6 Asbestos-Cement
 7 Fiberglass
 8 Concrete Tile
 9 Other (Specify below).....
 Blank casing diameter 2 in.
 Casing height above or below land surface in.
 Was casing pulled? Yes X No If yes, how much 20'

6 GROUT PLUG MATERIAL:
 1 Neat cement
 2 Cement grout
 3 Bentonite
 4 Other..... Surface silts and clays.....
 Grout Plug Intervals: From 3 to 20' ft. to 3 ft. From 3 ft. to 0 ft. From to ft.
 What is the nearest source of possible contamination:
 1 Septic tank
 2 Sewer lines
 3 Watertight sewer lines
 4 Lateral lines
 5 Cess pool
 6 Seepage pit
 7 Pit privy
 8 Sewage lagoon
 9 Feedyard
 10 Livestock pens
 11 Fuel storage
 12 Fertilizer storage
 13 Insecticide storage
 14 Abandoned water well
 15 Oil well/Gas well
 16 Other (specify below) Card. Silts
 Direction from well? How many feet?

FROM	TO	PLUGGING MATERIALS
0	3	Surface Silt and Clays
3	20'	Bentonite

7 CONTRACTOR'S OF LANDOWNER'S CERTIFICATION: This water well was plugged under my jurisdiction and was completed on 09/17/03 (mo/day/year) and this record is true to the best of my knowledge and belief. Kansas Water Well Contractor's License No. 585. This Water Well Record was completed on (mo/day/year) 09/17/03 under the business name of Associated Environmental, Inc. by (signature) Dana Duncan.

INSTRUCTIONS: Use typewriter or ball point pen. Please press firmly and print clearly. Please fill in blanks, underline or circle the correct answers. Send top three copies to Kansas Department of Health and Environment, Bureau of Water, Geology Section, 1000 SW Jackson St., Ste. 420, Topeka, Kansas 66612-1367. Telephone: 785/296-5522. Send one to Water Well Owner and retain one for your records.