

CORRECTION(S) TO WATER WELL RECORD (WWC-5)

(to rectify lacking or incorrect information)

County: Pottawatomie

Location listed as:

Section-Township-Range: 17-10S-10E

Fraction (1/4 1/4 1/4): Lot 6

Location changed to:

17-10S-10E

SW NW SW

Other changes: Initial statements: _____

Changed to: _____

Comments: _____

verification method: written & legal descriptions, position on plat map, and Wamego 1:24,000 topo. map (buildings shown on map).

initials: ARL date: 10/18/2004


submitted by: Kansas Geological Survey, Data Resources Library, 1930 Constant Ave., Lawrence, KS 66047-3726
to: Kansas Dept of Health & Environment, Bureau of Water, 1000 SW Jackson, Suite 420, Topeka, KS 66612-1367.

1 LOCATION OF WATER WELL: Fraction 1/4 Section Number 17 Township Number T 10 S Range Number R 10 E ~~XX~~
 County: POTTAWATOMIE X LOT 6 X

Distance and direction from nearest town or city street address of well if located within city?
1 MILE WEST OF WAMEGO KS., ON MILITARY TR. RD., TO HORSESHOE RD., 3/4 MILE SOUTH ON EAST SIDE

2 WATER WELL OWNER: TOM EBERT
 RR#, St. Address, Box # : 11650 LOUISVILLE RD. Board of Agriculture, Division of Water Resources
 City, State, ZIP Code : ST. GEORGE, KS 66535 Application Number: 45429

3 LOCATE WELL'S LOCATION WITH AN "X" IN SECTION BOX: X SW
 4 DEPTH OF COMPLETED WELL: 64 ft. ELEVATION: _____
 Depth(s) Groundwater Encountered 1. 19 ft. 2. _____ ft. 3. _____ ft.
 WELL'S STATIC WATER LEVEL 19 ft. below land surface measured on mo/day/yr 5-29-04
 Pump test data: Well water was 21 ft. after 1 hours pumping 500 gpm
 Est. Yield 1000 gpm Well water was 29 ft. after 2 hours pumping 800 gpm
 Bore Hole Diameter 32 in. to 64 ft., and _____ in. to _____ ft.
 WELL WATER TO BE USED AS: 5 Public water supply 8 Air conditioning 11 Injection well
 1 Domestic 3 Feedlot 6 Oil field water supply 9 Dewatering 12 Other (Specify below)
2 Irrigation 4 Industrial 7 Lawn and garden only 10 Monitoring well
 Was a chemical/bacteriological sample submitted to Department? Yes _____ No X If yes, mo/day/yr sample was submitted _____
 Water Well Disinfected? Yes _____ No X

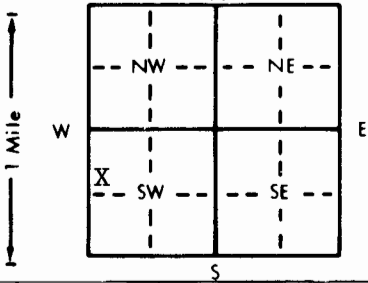

5 TYPE OF BLANK CASING USED: 1 Steel 3 RMP (SR) 5 Wrought iron 8 Concrete tile CASING JOINTS: Glued X Clamped X
 2 PVC 4 ABS 6 Asbestos-Cement 9 Other (specify below) Welded _____
 7 Fiberglass _____ Threaded _____
 Blank casing diameter 16 in. to 24 in. Dia _____ in. to _____ in. Dia _____ in. to _____ in. Dia _____
 Casing height above land surface 12 in., weight _____ lbs./ft. Wall thickness or gauge No. 50
 TYPE OF SCREEN OR PERFORATION MATERIAL: 7 PVC 10 Asbestos-cement
 1 Steel 3 Stainless steel 5 Fiberglass 8 RMP (SR) 11 Other (specify) _____
 2 Brass 4 Galvanized steel 6 Concrete tile 9 ABS 12 None used (open hole)
 SCREEN OR PERFORATION OPENINGS ARE: 5 Gauzed wrapped 8 Saw cut 11 None (open hole)
 1 Continuous slot 3 Mill slot 6 Wire wrapped 9 Drilled holes
 2 Louvered shutter 4 Key punched 7 Torch cut 10 Other (specify) _____
 SCREEN-PERFORATED INTERVALS: From 24 ft. to 64 ft., From _____ ft. to _____ ft.
 From _____ ft. to _____ ft., From _____ ft. to _____ ft.
 GRAVEL PACK INTERVALS: From 20 ft. to 64 ft., From _____ ft. to _____ ft.
 From _____ ft. to _____ ft., From _____ ft. to _____ ft.

6 GROUT MATERIAL: 1 Neat cement 2 Cement grout 3 Bentonite 4 Other _____
 Grout Intervals: From 0 ft. to 20 ft., From _____ ft. to _____ ft., From _____ ft. to _____ ft.
 What is the nearest source of possible contamination:
 1 Septic tank 4 Lateral lines 7 Pit privy 10 Livestock pens 14 Abandoned water well
 2 Sewer lines 5 Cess pool 8 Sewage lagoon 11 Fuel storage 15 Oil well/Gas well
 3 Watertight sewer lines 6 Seepage pit 9 Feedyard 12 Fertilizer storage 16 Other (specify below)
 _____ 13 Insecticide storage _____ NONE

Direction from well? _____ How many feet? _____

FROM	TO	LITHOLOGIC LOG	FROM	TO	PLUGGING INTERVALS
0	6	SANDY LOAM			
6	15	SILT			
15	24	MEDIUM GREY GRAVEL & CLAY			
24	27	MEDIUM-LARGE GREY GRAVEL & SMALL COBBLES			
27	28	LARGE GREY GRAVEL & LARGE COBBLES			
28	30	MEDIUM GREY GRAVEL & GREY CLAY			
30	42	MEDIUM GREY GRAVEL			
42	43	MEDIUM-LARGE GREY GRAVEL & LARGE COBBLES			
43	47	MEDIUM-LARGE GREY GRAVEL & GREY CLAY			
47	63	LARGE GREY GRAVEL & LARGE COBBLES			
63	64	GREEN SHALE, STOPPED			

7 CONTRACTOR'S OR LANDOWNER'S CERTIFICATION: This water well was (1) constructed, (2) reconstructed, or (3) plugged under my jurisdiction and was completed on (mo/day/year) 5-29-04 and this record is true to the best of my knowledge and belief. Kansas Water Well Contractor's License No. 323 This Water Well Record was completed on (mo/day/yr) 6-27-04 under the business name of HOUBLER DRILLING CO. by (signature) _____