


1 LOCATION OF WATER WELL: Fraction NE 1/4 NE 1/4 NW 1/4 Section Number 11 Township Number T 10 S Range Number R 10 EW  
 County: Pottawatomie  
 Distance and direction from nearest town or city street address of well if located within city? 1 E OF WAMEGO

2 WATER WELL OWNER: DAVID CARNAHAN  
 RR#, St. Address, Box #: RR 1 Board of Agriculture, Division of Water Resources  
 City, State, ZIP Code: Wamego 66597 Application Number:

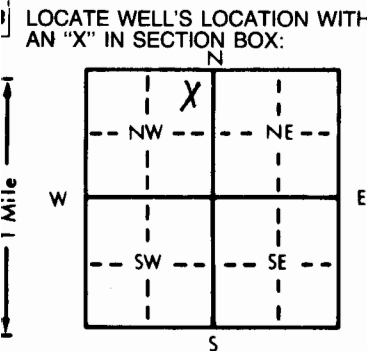

4 DEPTH OF COMPLETED WELL: 44 ft. ELEVATION: .....  
 Depth(s) Groundwater Encountered 1. 27 ft. 2. .... ft. 3. .... ft.  
 WELL'S STATIC WATER LEVEL 27 ft. below land surface measured on mo/day/yr 8-24-82  
 Pump test data: Well water was ..... ft. after ..... hours pumping ..... gpm  
 Est. Yield 40 gpm: Well water was ..... ft. after ..... hours pumping ..... gpm  
 Bore Hole Diameter 12 in. to 44 ft., and ..... in. to ..... ft.  
 WELL WATER TO BE USED AS:  
 5 Public water supply 8 Air conditioning 11 Injection well  
 1 Domestic 3 Feedlot 6 Oil field water supply 9 Dewatering 12 Other (Specify below)  
 2 Irrigation 4 Industrial 7 Lawn and garden only 10 Observation well  
 Was a chemical/bacteriological sample submitted to Department? Yes.....No ; If yes, mo/day/yr sample was submitted  
 Water Well Disinfected? Yes  No

5 TYPE OF BLANK CASING USED:  
 1 Steel 3 RMP (SR) 5 Wrought iron 8 Concrete tile CASING JOINTS: Glued  Clamped .....  
 2 PVC 4 ABS 6 Asbestos-Cement 9 Other (specify below) Welded .....  
 7 Fiberglass Threaded.....  
 Blank casing diameter 6 in. to 0-30 ft., Dia. 6 in. to 40-44 ft., Dia. .... in. to ..... ft.  
 Casing height above land surface 24 in., weight 3.58 lbs./ft. Wall thickness or gauge No. 280  
 TYPE OF SCREEN OR PERFORATION MATERIAL:  
 1 Steel 3 Stainless steel 5 Fiberglass 8 RMP (SR) 11 Other (specify) .....  
 2 Brass 4 Galvanized steel 6 Concrete tile 9 ABS 12 None used (open hole)

SCREEN OR PERFORATION OPENINGS ARE: JOHNSON PLASTIC  
 1 Continuous slot 3 Mill slot 25 SLOT 5 Gauzed wrapped 8 Saw cut 11 None (open hole)  
 2 Louvered shutter 4 Key punched 6 Wire wrapped 9 Drilled holes  
 7 Torch cut 10 Other (specify) .....  
 SCREEN-PERFORATED INTERVALS: From 30 ft. to 40 ft., From ..... ft. to ..... ft.  
 From ..... ft. to ..... ft., From ..... ft. to ..... ft.  
 GRAVEL PACK INTERVALS: From 10 ft. to 44 ft., From ..... ft. to ..... ft.  
 From ..... ft. to ..... ft., From ..... ft. to ..... ft.

6 GROUT MATERIAL: 1 Neat cement 2 Cement grout 3 Bentonite 4 Other .....  
 Grout intervals: From 0 ft. to 10 ft., From ..... ft. to ..... ft., From ..... ft. to ..... ft.  
 What is the nearest source of possible contamination:  
 1 Septic tank 4 Lateral lines 7 Pit privy 10 Livestock pens 14 Abandoned water well  
 2 Sewer lines 5 Cess pool 8 Sewage lagoon 11 Fuel storage 15 Oil well/Gas well  
 3 Watertight sewer lines 6 Seepage pit 9 Feedyard 12 Fertilizer storage 16 Other (specify below)  
 13 Insecticide storage  
 Direction from well? S How many feet? 95

FROM	TO	LITHOLOGIC LOG	FROM	TO	LITHOLOGIC LOG
0	6	TOP SOIL			
6	22	CLAY, BROWN			
22	25	FINE SAND, YELLOW			
25	28	FINE SAND, COURSE SAND, YELLOW			
28	40	" " " " MED. SAND, YELLOW			
40	44	" " " " BLUE			

7 CONTRACTOR'S OR LANDOWNER'S CERTIFICATION: This water well was (1) constructed, (2) reconstructed, or (3) plugged under my jurisdiction and was completed on (mo/day/year) 8-24-82 and this record is true to the best of my knowledge and belief. Kansas  
 Water Well Contractor's License No. 182 This Water Well Record was completed on (mo/day/yr) 9-10-82  
 under the business name of Strader Dr. & Co. Inc. by (signature) Dale Ashen  
 INSTRUCTIONS: Use typewriter or ball point pen, PLEASE PRESS FIRMLY and PRINT clearly. Please fill in blanks, underline or circle the correct answers. Send top three copies to Kansas Department of Health and Environment, Division of Environment, Environmental Geology Section, Topeka, KS 66620. Send one to WATER WELL OWNER and retain one for your records.

OFFICE USE ONLY  
T  
10  
R  
10  
EW  
SEC  
11  
NE  
NE  
NE  
NE