8L

USE TYPEWRITER OR BALL POINT PEN-PRESS FIRMLY, PRINT CLEARLY.

WATER WELL RECORD
KSA 82a-1201-1215

T R EW sec 1/4 1/4 1/4 No.

Kansas State Dept. Of Health
(Water Well Contractors)
Forbes-Bldg. 740
Topeka, Kansas 66620

1 Location of well: County	Township name	Fraction	Section number	Town number	Range number
Pottawattomie	Wamego	~~SW 1/4 SW 1/4 NE 1/4~~	~~18~~ 17	10	10

Distance and direction from nearest town or city: 1 SW

Street address of well location if in city: Wamego

3 Owner of well: Mrs. Milus Grothjan

Address: RFD 1 Wamego, Kans

Locate with "X" in section below:

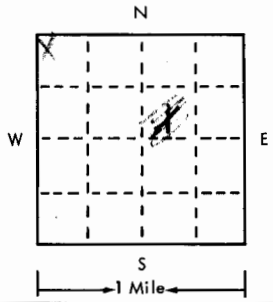

Sketch map:

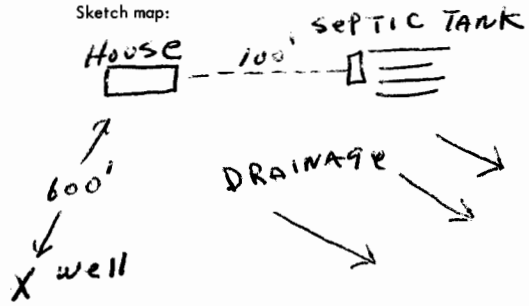

4 Well depth: 50 ft. Date of completion 9-26-75
Well diameter 8 in.

5 ☐ Cable tool ☒ Rotary ☐ Driven ☐ Dug
☐ Hollow rod ☐ Jetted ☐ Bored ☐ Reverse rotary

6 Use: ☒ Domestic ☐ Public supply ☐ Industry
☐ Irrigation ☐ Air conditioning ☐ Commercial
☐ Test well ☐

7 Casing: Material PVC Height: above/~~below~~
Threaded ☐ Welded ☐ Surface 24 in.
Diam. Weight 2.33 lbs./ft.
5 in. to 50 ft. depth Drive shoe? ☐ Yes ☒ No
in. to ft. depth

2 Type and color of material	From	To
Sandy Yellow Clay	0	15
Fine Sand	15	20
Coarse Sand	20	28
Grey Shale	28	37
Grey Lime	37	43
Blue Shale	43	50
(use a second sheet if needed)		

8 Screen:
Manufacturer Pump co
Type PVC Dia. 5"
Slot/~~gauge~~ 1025 Length 10'
Set between 25 ft. and 35 ft.
Fittings:
Gravel pack ☒ Yes ☐ No Size range of material #2

9 Static water level: Not Measured
19 ft. below land surface Date 9-26-75 mkc

10 Pumping level below land surfaces: Air Test
ft. after hrs. pumping g.p.m.
ft. after hrs. pumping g.p.m.
Estimated maximum yield 10 g.p.m.

11 Water sample submitted:
☑ Yes ☒ No Date

12 Well head completion: Capped
☐ Pitless adapter 24 ☒ Inches above grade

13 Well grouted? ☒ Yes ☐ No
☒ Neat cement ☐ Bentonite ☐
Depth: From 0 ft. to 20 ft.

14 Nearest source of possible contamination:
ft. 150 Direction E Type S. Tank
Well disinfected upon completion? ☒ Yes ☐ No

15 Pump: ☒ Not installed
Manufacturer's name
Model number HP Volts
Length of drop pipe ft. capacity g.m.p.
Type:
☐ Submersible ☐ Turbine
☐ Jet ☐ Reciprocating
☐ Certrifugal ☐ Other

16 Remarks: elevation
1025 Well slab install by Owner

Topography:
☐ Hill
☒ Slope
☐ Upland
☐ Valley

17 Water well contractor's certification:
This well was drilled under my jurisdiction and this report is true to the best of my knowledge and belief.
Strader Drlg Co Inc 182
Business name License No.
Address RFD 1 Holton Ks
Signed Dale Barker Date 9-28-75
Authorized representative

10 10E 18 SW SW NE

Forward the white, blue and pink copies to the Kansas State Dept. Of Health.

Form WWC-5

677-H