

CORRECTION(S) TO WATER WELL RECORD (WWC-5)

(to rectify lacking or incorrect information)

County: Pottawatomie

Location listed as:

Section-Township-Range: 1-9-10S-10-11EFraction ($\frac{1}{4}$ $\frac{1}{4}$ $\frac{1}{4}$): SW NE NW

Location changed to:

1-10S-10ESW NE NW

Other changes: Initial statements: _____

Changed to: _____


Comments: _____

verification method: Pottawatomie Co. map following directionsfrom city of Warsaw: 3 mi Einitials: E.P. date: 8/16/2005

1 LOCATION OF WATER WELL: Fraction SW 1/4 NE 1/4 NW 1/4 Section Number 1 Township Number T 9-10 S Range Number R 10-11 E/W
 County: Pottawatomie

Distance and direction from nearest town or city street address of well if located within city?
3 miles east of Whamego

2 WATER WELL OWNER: JAMES MACLINE
 RR#, St. Address, Box # : _____ Board of Agriculture, Division of Water Resources
 City, State, ZIP Code : BURN OAK, KANSAS Application Number: _____

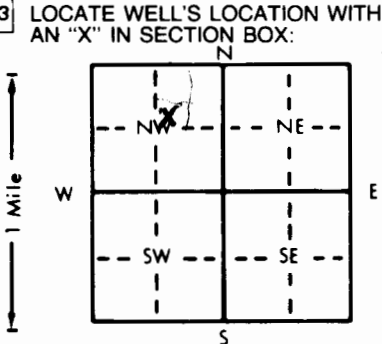

4 DEPTH OF COMPLETED WELL: 60 ft. ELEVATION: _____
 Depth(s) Groundwater Encountered 1. 23 ft. 2. _____ ft. 3. _____ ft.
 WELL'S STATIC WATER LEVEL 18 ft. below land surface measured on mo/day/yr 3-17-96
 Pump test data: Well water was _____ ft. after _____ hours pumping _____ gpm
 Est. Yield 1000+ gpm: Well water was _____ ft. after _____ hours pumping _____ gpm
 Bore Hole Diameter 30 in. to 60 ft., and _____ in. to _____ ft.
 WELL WATER TO BE USED AS:
 5 Public water supply 8 Air conditioning 11 Injection well
 1 Domestic 3 Feedlot 6 Oil field water supply 9 Dewatering 12 Other (Specify below)
2 Irrigation 4 Industrial 7 Lawn and garden only 10 Monitoring well _____
 Was a chemical/bacteriological sample submitted to Department? Yes _____ No X; If yes, mo/day/yr sample was submitted _____
 Water Well Disinfected? Yes X No _____

5 TYPE OF BLANK CASING USED:
 1 Steel 3 RMP (SR) 5 Wrought iron 8 Concrete tile CASING JOINTS: Glued X Clamped _____
2 PVC 4 ABS 6 Asbestos-Cement 9 Other (specify below) Welded _____
 7 Fiberglass Threaded _____
 Blank casing diameter 0 in. to 30 ft., Dia _____ in. to _____ ft., Dia _____ in. to _____ ft.
 Casing height above land surface 12 in., weight _____ lbs./ft. Wall thickness or gauge No. 1/4"
 TYPE OF SCREEN OR PERFORATION MATERIAL:
 1 Steel 3 Stainless steel 5 Fiberglass 8 RMP (SR) 10 Asbestos-cement
 2 Brass 4 Galvanized steel 6 Concrete tile 9 ABS 11 Other (specify) _____
 12 None used (open hole)
 SCREEN OR PERFORATION OPENINGS ARE:
 1 Continuous slot 3 Mill slot 5 Gauzed wrapped 8 Saw cut 11 None (open hole)
 2 Louvered shutter 4 Key punched 6 Wire wrapped 9 Drilled holes
 7 Torch cut 10 Other (specify) _____
 SCREEN-PERFORATED INTERVALS: From 30 ft. to 60 ft., From _____ ft. to _____ ft.
 From _____ ft. to _____ ft., From _____ ft. to _____ ft.
 GRAVEL PACK INTERVALS: From 20 ft. to 60 ft., From _____ ft. to _____ ft.
 From _____ ft. to _____ ft., From _____ ft. to _____ ft.

6 GROUT MATERIAL: 1 Neat cement 2 Cement grout 3 Bentonite 4 Other _____
 Grout Intervals: From 0 ft. to 20 ft., From _____ ft. to _____ ft., From _____ ft. to _____ ft.
 What is the nearest source of possible contamination:
 1 Septic tank 4 Lateral lines 7 Pit privy 10 Livestock pens 4 Abandoned water well
 2 Sewer lines 5 Cess pool 8 Sewage lagoon 11 Fuel storage 15 Oil well/Gas well
 3 Watertight sewer lines 6 Seepage pit 9 Feedyard 12 Fertilizer storage 16 Other (specify below)
 13 Insecticide storage _____
 Direction from well? EAST How many feet? 300-400'

FROM	TO	LITHOLOGIC LOG	FROM	TO	PLUGGING INTERVALS
0	3	TOPSOIL			
3	18	CLAY			
18	28	sand and GRAVEL			
28	60	Coarse River GRAVEL			
60		SHALE			

7 CONTRACTOR'S OR LANDOWNER'S CERTIFICATION: This water well was (1) constructed, (2) reconstructed, or (3) plugged under my jurisdiction and was completed on (mo/day/year) 3-17-96 and this record is true to the best of my knowledge and belief. Kansas Water Well Contractor's License No. 361 This Water Well Record was completed on (mo/day/yr) 6-19-96 under the business name of Cox-Beswick IRR. by (signature) Amie Beswick