

CORRECTION(S) TO WATER WELL RECORD (WWC-5)

(to rectify lacking or incorrect information)

County: Wabaunsee

Location listed as:

Location changed to:

Section-Township-Range: 16-105-10E

16-105-10E

Fraction ($\frac{1}{4}$ $\frac{1}{4}$ $\frac{1}{4}$): CW E $\frac{1}{2}$ NE

W2 E2 NE

Other changes: Initial statements: Pottawatomie County

Changed to: Wabaunsee County

Comments: _____

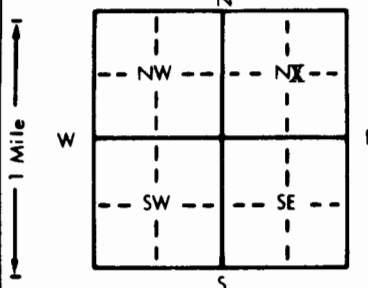
verification method: Written & legal descriptions, position on plat map, and Wamego 1:24,000 topo. map.

initials: DR date: 9/8/2005

1 LOCATION OF WATER WELL: Fraction Section Number Township Number Range Number
 County: POTTAWATOMIE CW ~~1/4~~ E 1/2 ~~1/4~~ NE 1/4 16 T 10 S R 10 E/W

Distance and direction from nearest town or city street address of well if located within city?
 SOUTH OF WAMEGO KS. ON US HWY. 99 1/2 MILE, 1/2 MILE EAST, & 1/4 MILE SOUTH

2 WATER WELL OWNER: LLOYD BANKS
 RR#, St. Address, Box # : 21905 HWY 24 EAST Board of Agriculture, Division of Water Resources
 City, State, ZIP Code : WAMEGO KS 66547 Application Number: 6600

3 LOCATE WELL'S LOCATION WITH AN "X" IN SECTION BOX:


4 DEPTH OF WELL... 56 ft. ELEVATION:
 Depth(s) Groundwater Encountered 1. ft. 2. ft. 3. ft.
 WELL'S STATIC WATER LEVEL . . . 16 ft. below land surface measured on mo/day/yr
 Pump test data: Well water was ft. after hours pumping gpm
 Est. Yield gpm: Well water was . . . N/A ft. after hours pumping gpm
 Bore Hole Diameter in. to ft., and in. to ft.
 WELL WATER TO BE USED AS: 5 Public water supply 8 Air conditioning 11 Injection well
 1 Domestic 3 Feedlot 6 Oil field water supply 9 Dewatering 12 Other (Specify below)
 2 Irrigation 4 Industrial 7 Lawn and garden only 10 Monitoring well
 Was a chemical/bacteriological sample submitted to Department? Yes No. ; If yes, mo/day/yr sample was sub-
 mitted Water Well Disinfected? Yes No

5 TYPE OF BLANK CASING USED:
 1 Steel 3 RMP (SR) 5 Wrought iron 8 Concrete tile CASING JOINTS: Glued Clamped
 2 PVC 4 ABS 6 Asbestos-Cement 9 Other (specify below) Welded
 Blank casing diameter . . . 16 . . . in. to . . . ft., Dia . . . in. to . . . ft., Dia . . . in. to . . . ft.
 Casing height ~~above~~ BELOW land surface . . . 36" . . . in., weight . . . lbs./ft. Wall thickness or gauge No.
 TYPE OF SCREEN OR PERFORATION MATERIAL:
 1 Steel 3 Stainless steel 5 Fiberglass 7 PVC 10 Asbestos-cement
 2 Brass 4 Galvanized steel 6 Concrete tile 8 RMP (SR) 11 Other (specify) NA
 9 ABS 12 None used (open hole)
 SCREEN OR PERFORATION OPENINGS ARE:
 1 Continuous slot 3 Mill slot 5 Gauzed wrapped 8 Saw cut 11 None (open hole)
 2 Louvered shutter 4 Key punched 6 Wire wrapped 9 Drilled holes
 7 Torch cut 10 Other (specify) NA
 SCREEN-PERFORATED INTERVALS: From . . . N/A / 999 . . . ft. to . . . ft., From . . . ft. to . . . ft., From . . . ft. to . . . ft.
 GRAVEL PACK INTERVALS: From . . . ft. to . . . ft., From . . . ft. to . . . ft., From . . . ft. to . . . ft.

6 GROUT MATERIAL: 1 Neat cement 2 Cement grout 3 Bentonite 4 Other
 Grout intervals: From . . . 16 . . . ft. to . . . 4 . . . ft., From . . . ft. to . . . ft., From . . . ft. to . . . ft.
 What is the nearest source of possible contamination:
 1 Septic tank 4 Lateral lines 7 Pit privy 10 Livestock pens 14 Abandoned water well
 2 Sewer lines 5 Cess pool 8 Sewage lagoon 11 Fuel storage 15 Oil well/Gas well
 3 Watertight sewer lines 6 Seepage pit 9 Feedyard 12 Fertilizer storage 16 Other (specify below)
 13 Insecticide storage
 Direction from well? How many feet?

FROM	TO	LITHOLOGIC LOG	FROM	TO	PLUGGING INTERVALS
			56	16	WASHED UD 1
			16	4	GRANULAR BENTONITE
			4	0	CASING CUT OFF & REMOVED
NOTE: MR. BANKS HAD 16, 50LBS BAGS OF BENTONITE FROM ABANDONING A HAND DUG WELL SEVERAL YEARS AGO, SO WE USED IT THE ENTIRE WAY ABOVE WATERLINE DAN					

7 CONTRACTOR'S OR LANDOWNER'S CERTIFICATION: This water well was (1) constructed, (2) reconstructed, or (3) plugged under my jurisdiction and was completed on (mo/day/year) . . . 5-4-98 and this record is true to the best of my knowledge and belief. Kansas Water Well Contractor's License No. . . . 323 This Water Well Record was completed on (mo/day/yr) . . . 5-7-98 . . .