


1 LOCATION OF WATER WELL: Fraction NW 1/4 NE 1/4 SW 1/4 Section Number 4 Township Number T 10 S Range Number R 10 E4N
 County: **POTTAWATOMIE**

Distance and direction from nearest town or city street address of well if located within city?
FIGGE DIL CO 1107 HWY WEST WAMEGO KS 66547

2 WATER WELL OWNER: **ATT: GALEN GLENN**
 RR#, St. Address, Box #: **308 N 4TH WEST MORLAND KS 66549** Board of Agriculture, Division of Water Resources
 City, State, ZIP Code: Application Number:

3 LOCATE WELL'S LOCATION WITH AN "X" IN SECTION BOX:

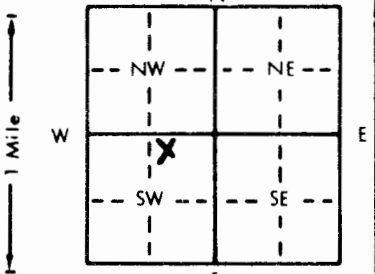

4 DEPTH OF COMPLETED WELL: **15** ft. ELEVATION:

Depth(s) Groundwater Encountered 1. **2.0** ft. 2. - ft. 3. - ft.
 WELL'S STATIC WATER LEVEL - ft. below land surface measured on mo/day/yr
 Pump test data: Well water was - ft. after - hours pumping - gpm
 Est. Yield - gpm: Well water was - ft. after - hours pumping - gpm
 Bore Hole Diameter: **8.625** in. to **15** ft. and - in. to - ft.
 WELL WATER TO BE USED AS:
 1 Domestic 3 Feedlot 6 Oil field water supply 9 Dewatering 12 Other (Specify below)
 2 Irrigation 4 Industrial 7 Lawn and garden only 10: Monitoring well
 Was a chemical/bacteriological sample submitted to Department? Yes - No **X**; If yes, mo/day/yr sample was submitted
 Water Well Disinfected? Yes - No **X**

5 TYPE OF BLANK CASING USED:
 1 Steel 3 RMP (SR) 5 Wrought iron 8 Concrete tile CASING JOINTS: Glued - Clamped -
 2 PVC 4 ABS 6 Asbestos-Cement 9 Other (specify below) Welded -
 7 Fiberglass Threaded **X**

Blank casing diameter **2** in. to **5** ft. Dia - in. to - ft. Dia - in. to - ft.
 Casing height above land surface **24** in., weight **SCH 40** lbs./ft. Wall thickness or gauge No. -

TYPE OF SCREEN OR PERFORATION MATERIAL:
 1 Steel 3 Stainless steel 5 Fiberglass 7 PVC 10 Asbestos-cement
 2 Brass 4 Galvanized steel 6 Concrete tile 8 RMP (SR) 11 Other (specify) -
 9 ABS 12 None used (open hole)

SCREEN OR PERFORATION OPENINGS ARE:
 1 Continuous slot 3 Mill slot 5 Gauzed wrapped 8 Saw cut 11 None (open hole)
 2 Louvered shutter 4 Key punched 6 Wire wrapped 9 Drilled holes
 7 Torch cut 10 Other (specify) -

SCREEN-PERFORATED INTERVALS: From **5** ft. to **15** ft. From - ft. to - ft.
 From - ft. to - ft. From - ft. to - ft.
~~SAND~~
~~GRAVEL~~ PACK INTERVALS: From **4** ft. to **15** ft. From - ft. to - ft.
 From - ft. to - ft. From - ft. to - ft.

6 GROUT MATERIAL: 1 Neat cement 2 Cement grout 3 Bentonite 4 Other -
 Grout Intervals: From **GL** ft. to **2** ft. From **2** ft. to **2** ft. From **4** ft. to - ft.

What is the nearest source of possible contamination:
 1 Septic tank 4 Lateral lines 7 Pit privy 10 Livestock pens 14 Abandoned water well
 2 Sewer lines 5 Cess pool 8 Sewage lagoon 11 Fuel storage 15 Oil well/Gas well
 3 Watertight sewer lines 6 Seepage pit 9 Feedyard 12 Fertilizer storage 16 Other (specify below)
 13 Insecticide storage

Direction from well? How many feet?

FROM	TO	LITHOLOGIC LOG	FROM	TO	PLUGGING INTERVALS
GL	2	SOIL-CLAY SILT			
2	5	SILTY CLAY			
5	10	CLAY SILT			
10	15	SILTY CLAY			
TD	15				

7 CONTRACTOR'S OR LANDOWNER'S CERTIFICATION: This water well was (1) constructed, (2) reconstructed, or (3) plugged under my jurisdiction and was completed on (mo/day/year) **07-20-94** and this record is true to the best of my knowledge and belief. Kansas Water Well Contractor's License No. **479** This Water Well Record was completed on (mo/day/yr) **07-26-94** under the business name of **EBBERTS DRILLING** by (signature) *Debra Ebberts*

INSTRUCTIONS: Use typewriter or ball point pen. PLEASE PRESS FIRMLY and PRINT clearly. Please fill in blanks, underline or circle the correct answers. Send top three copies to Kansas Department of Health and Environment, Bureau of Water, Topeka, Kansas 66620-0001. Telephone: 913-296-5545. Send one to WATER WELL OWNER and retain one for your records.

OFFICE USE ONLY
T
R
EW
SEC.