


1 LOCATION OF WATER WELL: Fraction NW 1/4 NE 1/4 SW 1/4 Section Number 4 Township Number T 10 S Range Number R 10 E/W

Distance and direction from nearest town or city street address of well if located within city?
FIGGE OIL CO 1107 HWY WEST WAMEBU KS 66547

2 WATER WELL OWNER: **ATT: GALEN GLENN**
 RR#, St. Address, Box # **308 N 4TH WESTMORLAND KS 66549**
 City, State, ZIP Code
 Board of Agriculture, Division of Water Resources
 Application Number:

3 LOCATE WELL'S LOCATION WITH AN "X" IN SECTION BOX:

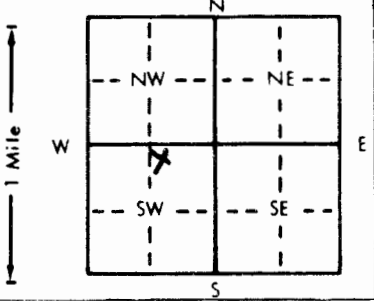

4 DEPTH OF COMPLETED WELL: **15** ft. ELEVATION:
 Depth(s) Groundwater Encountered 1. **8** ft. 2. **-** ft. 3. **-** ft.
 WELL'S STATIC WATER LEVEL **-** ft. below land surface measured on mo/day/yr
 Pump test data: Well water was **-** ft. after **-** hours pumping **-** gpm
 Est. Yield **-** gpm Well water was **-** ft. after **-** hours pumping **-** gpm
 Bore Hole Diameter **8.625** in. to **15** ft. and **-** in. to **-** ft.
 WELL WATER TO BE USED AS:
 5 Public water supply 8 Air conditioning 11 Injection well
 1 Domestic 3 Feedlot 6 Oil field water supply 9 Dewatering 12 Other (Specify below)
 2 Irrigation 4 Industrial 7 Lawn and garden only 10 Monitoring well
 Was a chemical/bacteriological sample submitted to Department? Yes **-** No **X**; If yes, mo/day/yr sample was submitted
 Water Well Disinfected? Yes **-** No **X**

5 TYPE OF BLANK CASING USED:
 1 Steel 3 RMP (SR) 5 Wrought iron 8 Concrete tile CASING JOINTS: Glued **-** Clamped **-**
 2 PVC 4 ABS 6 Asbestos-Cement 9 Other (specify below) Welded **-**
 7 Fiberglass Threaded **X**
 Blank casing diameter **2** in. to **5** ft. Dia. **-** in. to **-** ft. Dia. **-** in. to **-** ft.
 Casing height above land surface **FLUSH** in., weight **SCH 40** lbs./ft. Wall thickness or gauge No. **-**
 TYPE OF SCREEN OR PERFORATION MATERIAL:
 1 Steel 3 Stainless steel 5 Fiberglass 7 PVC 10 Asbestos-cement
 2 Brass 4 Galvanized steel 6 Concrete tile 8 RMP (SR) 11 Other (specify below)
 9 ABS 12 None used (open hole)
 SCREEN OR PERFORATION OPENINGS ARE:
 1 Continuous slot 3 Mill slot 5 Gauzed wrapped 8 Saw cut 11 None (open hole)
 2 Louvered shutter 4 Key punched 6 Wire wrapped 9 Drilled holes
 7 Torch cut 10 Other (specify below)
 SCREEN-PERFORATED INTERVALS: From **S** ft. to **15** ft. From **-** ft. to **-** ft.
SAND From **-** ft. to **-** ft. From **-** ft. to **-** ft.
 GRAVEL PACK INTERVALS: From **4** ft. to **15** ft. From **-** ft. to **-** ft.
 From **-** ft. to **-** ft. From **-** ft. to **-** ft.

6 GROUT MATERIAL: 1 Neat cement 2 Cement grout 3 Bentonite 4 Other
 Grout Intervals: From **GL** ft. to **2** ft. From **2** ft. to **4** ft. From **-** ft. to **-** ft.
 What is the nearest source of possible contamination:
 1 Septic tank 4 Lateral lines 7 Pit privy 10 Livestock pens 14 Abandoned water well
 2 Sewer lines 5 Cess pool 8 Sewage lagoon 11 Fuel storage 15 Oil well/Gas well
 3 Watertight sewer lines 6 Seepage pit 9 Feedyard 12 Fertilizer storage 16 Other (specify below)
 13 Insecticide storage **CONTAMINATED SITE**
 Direction from well? **-** How many feet? **-**

| FROM | TO | LITHOLOGIC LOG | FROM | TO | PLUGGING INTERVALS |
|------|----|----------------|------|----|--------------------|
| GL | 2 | GRAVEL | | | |
| 2 | 7 | CLAY SILT | | | |
| 7 | 15 | SILTY CLAY | | | |
| TD | 15 | | | | |

WAIVER - DON TAYLOR - 02-18-94

7 CONTRACTOR'S OR LANDOWNER'S CERTIFICATION: This water well was (1) constructed, (2) reconstructed, or (3) plugged under my jurisdiction and was completed on (mo/day/year) **07-20-94** and this record is true to the best of my knowledge and belief. Kansas Water Well Contractor's License No. **479** This Water Well Record was completed on (mo/day/yr) **07-26-94** under the business name of **EBBERTS DRILLING** by (signature) *[Signature]*

OFFICE USE ONLY

T

R

EW

SEC.

1/2

1/2