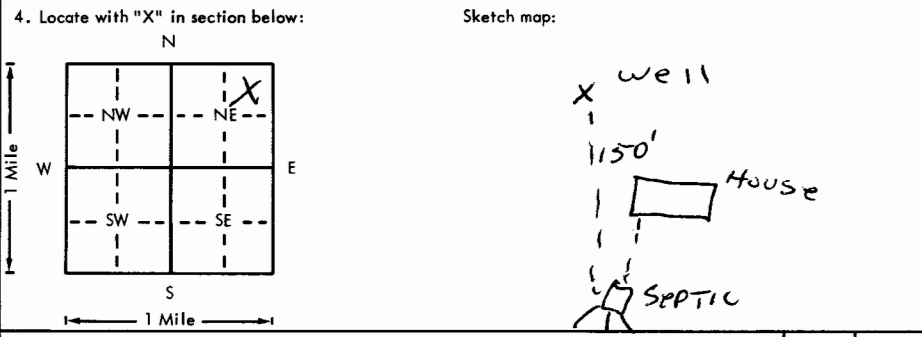


72

USE TYPEWRITER OR BALL POINT PEN-PRESS FIRMLY, PRINT CLEARLY.

WATER WELL RECORD
KSA 82a-1201-1215

Kansas Department of Health and Environment-Division of Environment
(Water well Contractors)
Topeka, Kansas 66620

1. Location of well: County <u>POTAWATOMIE</u> Fraction <u>NE 1/4 NE 1/4 NE 1/4</u> Section number <u>9</u> Township number <u>T 10</u> Range number <u>S R 10</u> EW	
2. Distance and direction from nearest town or city: <u>.5 E OF</u> Street address of well location if in city: <u>WAMEGO</u> 3. Owner of well: <u>DON DOILY</u> R.R. or street: <u>Hwy. 24E</u> City, state, zip code: <u>WAMEGO, KS</u>	
4. Locate with "X" in section below: Sketch map: 	
5. Type and color of material	
	From To
<u>TOP SOIL</u>	<u>0 6</u>
<u>Clay, Brown</u>	<u>6 33</u>
<u>FINE SAND</u>	<u>33 39</u>
<u>GRAVEL</u>	<u>39 47</u>
(Use a second sheet if needed)	
18. Elevation: <u>1015</u> Topography: <input type="checkbox"/> Hill <input type="checkbox"/> Slope <input type="checkbox"/> Upland <input checked="" type="checkbox"/> Valley	19. Remarks: <u>OWNER TO INSTAL SLAB</u>
20. Water well contractor's certification: This well was drilled under my jurisdiction and this report is true to the best of my knowledge and belief. <u>STEADER DOILY CO INC 182</u> Business name License No. Address <u>HATTON, KS</u> Signed <u>DATE GARDNER</u> Date <u>2-21-77</u> Authorized representative	

T 10 R 10 S 10 W 4 NE NE NE

Forward the white, blue and pink copies to the Department of Health and Environment

Form WWC-5