7

USE TYPEWRITER OR BALL POINT PEN-PRESS FIRMLY, PRINT CLEARLY.

T R EW sec 1/4 1/4 1/4 No.

WATER WELL RECORD
KSA 82a-1201-1215

Kansas State Dept. Of Health
(Water Well Contractors)
Forbes-Bldg. 740
Topeka, Kansas 66620

1 Location of well:	County	Township name	Fraction	Section number	Town number	Range number
	Pottawatomie	Wamego	Tract NW 1/4	6	10	10 E

Distance and direction from nearest town or city: 3 NW Wamego, Ks

Street address of well location if in city:

3 Owner of well: Huppe

Address: Wamego, Kansas

Locate with "X" in section below:

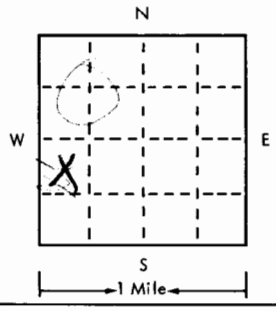

Sketch map:

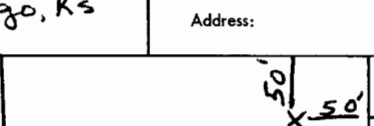

4 Well depth: 100 ft. Date of completion 5-1-75
Well diameter 12 in.

5 ☐ Cable tool ☒ Rotary ☐ Driven ☐ Dug ☐ Hollow rod ☐ Jetted ☐ Bored ☐ Reverse rotary

6 Use: ☒ Domestic ☐ Public supply ☐ Industry ☐ Irrigation ☐ Air conditioning ☐ Commercial ☐ Test well ☐

7 Casing: Material PVC
Threaded ☐ Welded ☐
Diam. 6 in. to 100 ft. depth
___ in. to ___ ft. depth
Height: above/below Surface 24 in.
Weight 2.33 lbs./ft.
Drive shoe? ☐ Yes ☒ No

2

Type and color of material	From	To
Top Soil	0	6
Br. Clay	6	50
Fine Sand	50	60
Coarse Sand	60	74
Rock Shale	74	100
(use a second sheet if needed)		

8 Screen:
Manufacturer Pumpco
Type PVC Dia. 5"
Slot/~~gauge~~ .025 Length 10
Set between 65 ft. and 75 ft.
Fittings:
Gravel pack ☒ Yes ☐ No Size range of material #3

9 Static water level: Not Measured ft. below land surface Date

10 Pumping level below land surfaces: Air Test
___ ft. after ___ hrs. pumping ___ g.p.m.
___ ft. after ___ hrs. pumping ___ g.p.m.
Estimated maximum yield 15 g.p.m.

11 Water sample submitted: ☐ Yes ☒ No Date

12 Well head completion: Capped
☐ Pitless adapter 24 ☐ Inches above grade

13 Well grouted? ☒ Yes ☐ No
☒ Neat cement ☐ Bentonite ☐
Depth: From 0 ft. to 10 ft.

14 Nearest source of possible contamination:
ft. 150 Direction East Type Septic Tank
Well disinfected upon completion? ☒ Yes ☐ No

15 Pump: ☒ Not installed
Manufacturer's name
Model number HP Volts
Length of drop pipe ft. capacity g.m.p.
Type:
☐ Submersible ☐ Turbine
☐ Jet ☐ Reciprocating
☐ Certrifugal ☐ Other

16 Remarks: elevation

1(6)

Topography:
☒ Hill
☐ Slope
☐ Upland
☐ Valley

17 Water well contractor's certification:
This well was drilled under my jurisdiction and this report is true to the best of my knowledge and belief.
Business name Strader Drilling Co. Inc. License No. #182
Address Rt. 75N Holton, Kans.
Signed [signature] Date 5-4-75
Authorized representative

Forward the white, blue and pink copies to the Kansas State Dept. Of Health.

Form WWC-5

677-H