


COPY - PS

1 LOCATION OF WATER WELL: County: Pottawatomie Fraction SE 1/4 SE 1/4 SE 1/4 Section Number 9 Township Number T 10 S Range Number R 10 EW

Distance and direction from nearest town or city street address of well if located within city?

2 WATER WELL OWNER: City of Wamego RR#, St. Address, Box #: 426 Lincoln WELL #8 City, State, ZIP Code: Wamego, KS 66547 Board of Agriculture, Division of Water Resources Application Number:

3 LOCATE WELL'S LOCATION WITH AN "X" IN SECTION BOX: 4 DEPTH OF COMPLETED WELL: 54 ft. ELEVATION:

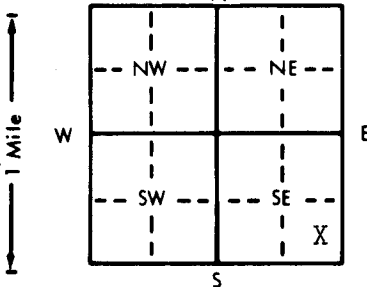

Depth(s) Groundwater Encountered 1. ft. 2. ft. 3. ft.
 WELL'S STATIC WATER LEVEL . . . 31.7 . . . ft. below land surface measured on mo/day/yr 4/19/82
 Pump test data: Well water was ft. after hours pumping gpm
 Est. Yield 500 gpm: Well water was 40.5 ft. after 6 hours pumping 548 gpm
 Bore Hole Diameter . . . 22 . . . in. to . . . 54 . . . ft., and in. to ft.
 WELL WATER TO BE USED AS: 5 Public water supply 8 Air conditioning 11 Injection well
 1 Domestic 3 Feedlot 6 Oil field water supply 9 Dewatering 12 Other (Specify below)
 2 Irrigation 4 Industrial 7 Lawn and garden only 10 Observation well
 Was a chemical/bacteriological sample submitted to Department? Yes No If yes, mo/day/yr sample was sub-
 mitted Water Well Disinfected? Yes No

5 TYPE OF BLANK CASING USED: 5 Wrought iron 8 Concrete tile CASING JOINTS: Glued Clamped
 1 Steel 3 RMP (SR) 6 Asbestos-Cement 9 Other (specify below) Welded X
 2 PVC 4 ABS 7 Fiberglass Threaded
 Blank casing diameter 12 in. to 0-39 ft., Dia in. to ft., Dia in. to ft.
 Casing height above land surface 30 in., weight 49.56 lbs./ft. Wall thickness or gauge No. 375

TYPE OF SCREEN OR PERFORATION MATERIAL: 7 PVC 10 Asbestos-cement
 1 Steel 3 Stainless steel Johnson 5 Fiberglass 8 RMP (SR) 11 Other (specify)
 2 Brass 4 Galvanized steel 6 Concrete tile 9 ABS 12 None used (open hole)

SCREEN OR PERFORATION OPENINGS ARE: 5 Gauzed wrapped 8 Saw cut 11 None (open hole)
 1 Continuous slot 3 Mill slot 6 Wire wrapped 9 Drilled holes
 2 Louvered shutter 4 Key punched 7 Torch cut 10 Other (specify)

SCREEN-PERFORATED INTERVALS: From 39 ft. to 54 ft., From ft. to ft.
 From ft. to ft., From ft. to ft.
 GRAVEL PACK INTERVALS: From 20 ft. to 54 ft., From ft. to ft.
 From ft. to ft., From ft. to ft.

6 GROUT MATERIAL: 1 Neat cement 2 Cement grout 3 Bentonite 4 Other
 Grout Intervals: From 0 ft. to 20 ft., From ft. to ft., From ft. to ft.

What is the nearest source of possible contamination:
 1 Septic tank 4 Lateral lines 7 Pit privy 10 Livestock pens 14 Abandoned water well
 2 Sewer lines 5 Cess pool 8 Sewage lagoon 11 Fuel storage 15 Oil well/Gas well
 3 Watertight sewer lines 6 Seepage pit 9 Feedyard 12 Fertilizer storage 16 Other (specify below)
 13 Insecticide storage
 Direction from well? WEST How many feet? 400

FROM	TO	LITHOLOGIC LOG	FROM	TO	LITHOLOGIC LOG
0	5	Top Soil			
5	21	Clay, Brown			
21	27	Clay, Grey			
27	32	Fine Sand, Coarse Sand, Brown			
32	38	Fine Sand, Coarse Sand, Brown, Med. Gravel			
38	41	Fine Sand, Coarse Sand, Brown, Med. Gravel, some pea gravel, brown			
41	54	Fine Sand, Coarse Sand, Med. Gravel, Pea Gravel, Brown			

7 CONTRACTOR'S OR LANDOWNER'S CERTIFICATION: This water well was (1) constructed, (2) reconstructed, or (3) plugged under my jurisdiction and was completed on (mo/day/year) . . . 5-03-82 and this record is true to the best of my knowledge and belief. Kansas Water Well Contractor's License No. 182 This Water Well Record was completed on (mo/day/yr) . . . 5-04-82 under the business name of Strader Drilling Co., Inc. by (signature) Dale Ashen

INSTRUCTIONS: Use typewriter or ball point pen, PLEASE PRESS FIRMLY and PRINT clearly. Please fill in blanks, underline or circle the correct answers. Send top three copies to Kansas Department of Health and Environment, Division of Environment, Environmental Geology Section, Topeka, KS 66620. Send one to WATER WELL OWNER and retain one for your records.

OFFICE USE ONLY T 10 R 10 EW SEC. 9 SE 1/4 SE 1/4 SE 1/4