Sent to BWS
1-15-79

USE TYPEWRITER OR BALL POINT PEN-PRESS FIRMLY, PRINT CLEARLY.

WATER WELL RECORD
KSA 82a-1201-1215

Kansas Department of Health and Environment-Division of Environment
(Water well Contractors)
Topeka, Kansas 66620

1. Location of well:	County	Fraction	Section number	Township number	Range number
	Pottawatomie	NW 1/4 NW 1/4 NW 1/4	10	T 10 (S)	R 10 (E) W

2. Distance and direction from nearest town or city: Compactor
Street address of well location if in city: Site in Wamego

3. Owner of well: Wamego City Test Well
R.R. or street: City Hall
City, state, zip code: Wamego, Ks. 66547

4. Locate with "X" in section below:

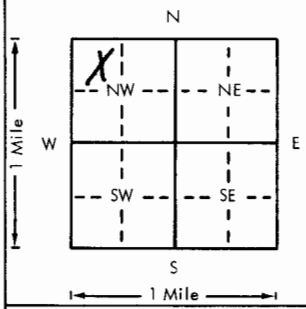

Sketch map:

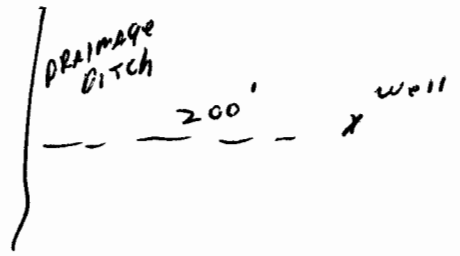

6. Bore hole dia. 12 in. Completion date _____
Well depth 77 ft. 12-26-78

7. __ Cable tool ✓ Rotary __ Driven __ Dug
__ Hollow rod __ Jetted __ Bored __ Reverse rotary

8. Use: Test well __ Domestic __ Public supply __ Industry
__ Irrigation __ Air conditioning __ Stock
__ Lawn __ Oil field water ✓ Other

9. Casing: Material PVC Height: (Above) or below
Threaded ___ Welded ___ Surface 24 in.
RMP ___ PVC 9L Weight 4.02 lbs./ft.
Dia. 6 in. to 77 ft. depth Wall Thickness: inches or
Dia. ___ in. to ___ ft. depth gage No. .316

5. Type and color of material	From	To
Top Soil	0	4
Clay, Brown	4	28
Fine Sand	28	30
Fine Sand, Course Sand, water bearing ~~med gr. Beige~~	30	34
Fine Sand, Course Sand, med gr. Pea gr. (yellow)	34	55
Fine Sand, Course Sand, Pea gr. - (Green)	55	75
Chert Gravel 1/4 x 1/2 Clean, (Blue)	75	79
Limestone	79	

(Use a second sheet if needed)

10. Screen: Manufacturer's name Rumpco MPI
Type PVC Dia. 6
(Slot) gauze .080 Length 20
Set between 57 ft. and 77 ft.
___ ft. and ___ ft.
Gravel pack? ✓ Size range of material 1/4 x 1/8

11. Static water level: mo./day/yr.
32 ft. below land surface Date 12-26-78

12. Pumping level below land surfaces:
___ ft. after ___ hrs. pumping ___ g.p.m.
___ ft. after ___ hrs. pumping ___ g.p.m.
Estimated maximum yield ___ g.p.m.

13. Water sample submitted: mo./day/yr.
✓ Yes ___ No ~~Date~~ 2-8-79

14. Well head completion: Cap
___ Pitless adapter 24 Inches above grade

15. Well grouted? NO GROUT, Test well
With: ___ Neat cement ___ Bentonite ___ Concrete
Depth: From ___ ft. to ___ ft.

16. Nearest source of possible contamination:
ft. 200 Direction W Type Drainage
Well disinfected upon completion? ✓ Yes ___ No

17. Pump: Test Pump Not installed
Manufacturer's name ___
Model number ___ HP ___ Volts ___
Length of drop pipe ___ ft. capacity ___ g.p.m.
Type:
___ Submersible ___ Turbine
___ Jet ___ Reciprocating
___ Centrifugal ___ Other

18. Elevation:

Topography:
___ Hill
___ Slope
___ Upland
✓ Valley

19. Remarks:
Casing will be pulled, Hole plugged

20. Water well contractor's certification:
This well was drilled under my jurisdiction and this report is true to the best of my knowledge and belief.
Business name Strader Drlg Co License No. 182
Address Holton Ks
Signed Zehner Rupp Authorized representative Date 1-3-78

T 10 R 10 (E) W Sec 10 1/4 NW 1/4 NW 1/4

Forward the white, blue and pink copies to the Department of Health and Environment

Form WWC-5

MI-1023