

Pcmw-3

WATER WELL RECORD


Form WWC-5

Division of Water Resources App. No.

1 LOCATION OF WATER WELL: County: Pottawotomie, Fraction: 1/4 SE 1/4 NE 1/4 NW 1/4, Section Number: 9, Township No.: T 10 S, Range Number: R 10 [X]E [ ]W

Street/Rural Address of Well Location; if unknown, distance & direction from nearest town or intersection: Lincoln St. & Ash St. between 4th & 5th St. Warnego, Ks. Global Positioning System (GPS) information: Latitude: 39.201117, Longitude: -96.3055145

2 WATER WELL OWNER: KDHE / BER, RR#, Street Address, Box #: 1000 SW Jackson St., Suite 410, City, State, ZIP Code: Topeka, Ks. 66612-1367. Collection Method: [ ] GPS unit, [ ] Digital Map/Photo, [ ] Topographic Map, [ ] Land Survey

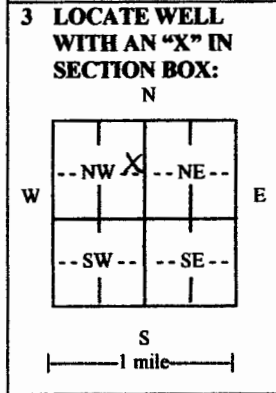

3 LOCATE WELL WITH AN 'X' IN SECTION BOX: [Diagram] 4 DEPTH OF COMPLETED WELL: 48 ft. Depth(s) Groundwater Encountered (1) 40.0 ft. (2) ... ft. (3) ... ft. WELL'S STATIC WATER LEVEL: 35.18 ft. below land surface measured on mo/day/yr. 7/31/2013

5 TYPE OF CASING USED: [ ] Steel [X] PVC [ ] Other CASING JOINTS: [ ] Glued [ ] Clamped [ ] Welded [X] Threaded Casing diameter .2 in. to .38 ft., Diameter ... in. to ... ft., Diameter ... in. to ... ft. Casing height above land surface 0 in., Weight ... lbs./ft., Wall thickness or gauge No. sch 40

TYPE OF SCREEN OR PERFORATION MATERIAL: [ ] Steel [ ] Stainless Steel [X] PVC [ ] Other (Specify) ... SCREEN OR PERFORATION OPENINGS ARE: [ ] Continuous slot [X] Mill slot [ ] Gauze wrapped [ ] Torch cut [ ] Drilled holes [ ] None (open hole) SCREEN-PERFORATED INTERVALS: From .38 ft. to .48 ft., From ... ft. to ... ft. GRAVEL PACK INTERVALS: From .35 ft. to .48 ft., From ... ft. to ... ft.

6 GROUT MATERIAL: [ ] Neat cement [X] Cement grout [ ] Bentonite [ ] Other Grout Intervals: From 0 ft. to 35 ft., From ... ft. to ... ft., From ... ft. to ... ft. What is the nearest source of possible contamination: [ ] Septic tank [ ] Lateral lines [ ] Pit privy [ ] Livestock pens [ ] Insecticide storage [ ] Other (specify below)

Table with columns: FROM, TO, LITHOLOGIC LOG, FROM, TO, LITHO. LOG (cont.) or PLUGGING INTERVALS. Rows describe soil layers from 0 to 48 feet depth.

7 CONTRACTOR'S OR LANDOWNER'S CERTIFICATION: This water well was [X] constructed, [ ] reconstructed, or [ ] plugged under my jurisdiction and was completed on (mo/day/year) 7/15/2013 and this record is true to the best of my knowledge and belief. Kansas Water Well Contractor's License No. 604. This Water Well Record was completed on (mo/day/year) 9/26/13 under the business name of Environmental Priority Service, Inc. by (signature) [Signature]

INSTRUCTIONS: Use typewriter or ball point pen. PLEASE PRESS FIRMLY and PRINT clearly. Please fill in blanks and check the correct answers. Send one copy to Kansas Department of Health and Environment, Bureau of Water, Geology Section, 1000 SW Jackson St., Suite 420, Topeka, Kansas 66612-1367. Telephone 785-296-5524. Send one copy to WATER WELL OWNER and retain one for your records. Include fee of \$5.00 for each constructed well. Visit us at http://www.kdheks.gov/waterwell/index.html