


1 LOCATION OF WATER WELL: County: POTTAWATOMIE	Fraction SE 1/4 NW 1/4 NW 1/4	Section Number 6	Township Number T 10 S	Range Number R 10 E/W
--	---	----------------------------	----------------------------------	---------------------------------

Distance and direction from nearest town or city street address of well if located within city?
1 3/4 west, 1/4 north of Wamego

2 WATER WELL OWNER: **Ed Phillips**
 RR#, St. Address, Box # : **1407 W Hiway 24**
 City, State, ZIP Code : **Wamego, KS 66547**
 Board of Agriculture, Division of Water Resources
 Application Number:

3 LOCATE WELL'S LOCATION WITH AN "X" IN SECTION BOX:

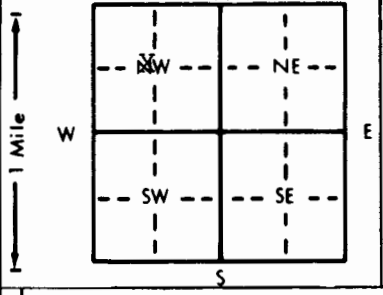

4 DEPTH OF COMPLETED WELL... **110'** ft. ELEVATION: ft.
 Depth(s) Groundwater Encountered 1. **74'** ft. 2. ft. 3. ft.
 WELL'S STATIC WATER LEVEL **55'** ft. below land surface measured on mo/day/yr **2-28-95**
 Pump test data: Well water was ft. after hours pumping gpm
 Est. Yield **.6** gpm: Well water was ft. after hours pumping gpm
 Bore Hole Diameter **.12"** in. to ft., and in. to ft.
 WELL WATER TO BE USED AS:
 5 Public water supply 8 Air conditioning 11 Injection well
 1 Domestic 3 Feedlot 6 Oil field water supply 9 Dewatering 12 Other (Specify below)
 2 Irrigation 4 Industrial 7 Lawn and garden only 10 Monitoring well
 Was a chemical/bacteriological sample submitted to Department? Yes.....No.....**X**...; If yes, mo/day/yr sample was submitted
 Water Well Disinfected? Yes **X** No

5 TYPE OF BLANK CASING USED:
 1 Steel 3 RMP (SR) 5 Wrought iron 8 Concrete tile CASING JOINTS: Glued **X** Clamped
 2 PVC 4 ABS 6 Asbestos-Cement 9 Other (specify below) Welded
 7 Fiberglass Threaded
 Blank casing diameter **5"** in. to **0-60** ft., Dia. **5"** in. to **76-109** ft., Dia. in. to ft.
 Casing height above land surface **24"** in., weight **2.82** lbs./ft. Wall thickness or gauge No. **258**
 TYPE OF SCREEN OR PERFORATION MATERIAL:
 1 Steel 3 Stainless steel 5 Fiberglass 7 PVC 10 Asbestos-cement
 2 Brass 4 Galvanized steel 6 Concrete tile 8 RMP (SR) 11 Other (specify)
 9 ABS 12 None used (open hole)
 SCREEN OR PERFORATION OPENINGS ARE:
 1 Continuous slot 3 Mill slot 5 Gauzed wrapped 8 Saw cut 11 None (open hole)
 2 Louvered shutter 4 Key punched 6 Wire wrapped 9 Drilled holes
 7 Torch cut 10 Other (specify)
 SCREEN-PERFORATED INTERVALS: From **60** ft. to **76** ft., From ft. to ft.
 From **109** ft. to **110** ft., From ft. to ft.
 GRAVEL PACK INTERVALS: From **24** ft. to **110** ft., From ft. to ft.
 From ft. to ft., From ft. to ft.

6 GROUT MATERIAL: 1 Neat cement 2 Cement grout 3 Bentonite 4 Other
 Grout Intervals: From **4** ft. to **24** ft., From ft. to ft., From ft. to ft.
 What is the nearest source of possible contamination:
 1 Septic tank 4 Lateral lines 7 Pit privy 10 Livestock pens 14 Abandoned water well
 2 Sewer lines 5 Cess pool 8 Sewage lagoon 11 Fuel storage 15 Oil well/Gas well
 3 Watertight sewer lines 6 Seepage pit 9 Feedyard 12 Fertilizer storage 16 Other (specify below)
 13 Insecticide storage
 Direction from well? **east** How many feet? **250'**

FROM	TO	LITHOLOGIC LOG	FROM	TO	PLUGGING INTERVALS
0	47	Clay-Brown-Silty			
47	74	Fine Sand-Brown			
74	84	Clay-Grey			
84	85	Boulders			
85	87	Clay-Blue			
87	107	Shale-Grey			
107	110	Limestone-Grey			

7 CONTRACTOR'S OR LANDOWNER'S CERTIFICATION: This water well was (1) constructed, (2) reconstructed, or (3) plugged under my jurisdiction and was completed on (mo/day/year) **2-28-95** and this record is true to the best of my knowledge and belief. Kansas Water Well Contractor's License No. **182** This Water Well Record was completed on (mo/day/yr) **3-23-95** under the business name of **STRADER DRILLING CO., INC.** by (signature) *Ed Phillips*

OFFICE USE ONLY

T

R

EW

SEC.

1/4

1/4

1/4