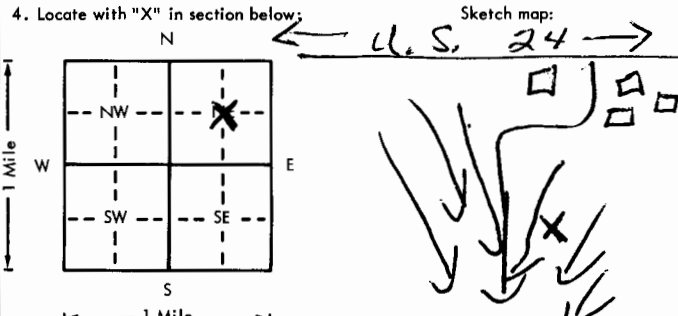


USE TYPEWRITER OR BALL POINT PEN—PRESS FIRMLY, PRINT CLEARLY.

WATER WELL RECORD  
KSA 82a-1201-1215

Kansas Department of Health and Environment—Division of Environment (Water well Contractors)  
Topeka, Kansas 66620

1. Location of well:	County <b>Pottawatomie</b>	Fraction <b>Center of 1/4 NE 1/4</b>	Section number <b>2</b>	Township number <b>T 10 S R 11 E/W</b>	Range number <b>11 E/W</b>
2. Distance and direction from nearest town or city: <b>2 mi. East of Belvue, Ks. on highway U.S. 24</b> Street address of well location if in city:			3. Owner of well: <b>A. Audentia Rollin</b> R.R. or street: <b>1201 Hoal Pkwy.</b> City, state, zip code: <b>Kansas City, Ks. 66102</b>		
4. Locate with "X" in section below: 			6. Bore hole dia. <b>30</b> in. Completion date <b>12-28-77</b> Well depth <b>58</b> ft.		
5. Type and color of material			7. <input type="checkbox"/> Cable tool <input type="checkbox"/> Rotary <input type="checkbox"/> Driven <input type="checkbox"/> Dug <input type="checkbox"/> Hollow rod <input type="checkbox"/> Jetted <input type="checkbox"/> Bored <input checked="" type="checkbox"/> Reverse rotary		
			8. Use: <input type="checkbox"/> Domestic <input type="checkbox"/> Public supply <input type="checkbox"/> Industry <input checked="" type="checkbox"/> Irrigation <input type="checkbox"/> Air conditioning <input type="checkbox"/> Stock <input type="checkbox"/> Lawn <input type="checkbox"/> Oil field water <input type="checkbox"/> Other		
			9. Casing: Material <b>Trans.</b> Height (Above) or below Threaded <input type="checkbox"/> Welded <input type="checkbox"/> Surface <b>24"</b> in. RMP <input type="checkbox"/> PVC <input type="checkbox"/> Weight _____ lbs./ft. Dia. <b>16</b> in. to <b>32</b> ft. depth; Wall Thickness: inches or Dia. _____ in. to _____ ft. depth; gage No. <b>.75"</b>		
			10. Screen: Manufacturer's name <b>Johnson Well Casing Co.</b> Type <b>Transite</b> Dia. <b>16"</b> (Slot) gauze <b>1/8 x 8</b> Length <b>26'</b> Set between <b>32'</b> ft. and <b>58'</b> ft. _____ ft. and _____ ft. Gravel pack? <b>yes</b> Size range of material <b>1/8-1/4"</b>		
			11. Static water level: _____ mo./day/yr. <b>15</b> ft. below land surface Date <b>12-28-77</b>		
			12. Pumping level below land surfaces: <b>27</b> ft. after <b>1</b> hrs. pumping <b>1000</b> g.p.m. <b>33</b> ft. after <b>3</b> hrs. pumping <b>1200</b> g.p.m. Estimated maximum yield <b>1500</b> g.p.m.		
			13. Water sample submitted: _____ mo./day/yr. Yes <input checked="" type="checkbox"/> No <input type="checkbox"/> Date _____		
			14. Well head completion: <input type="checkbox"/> Pitless adapter _____ inches above grade		
			15. Well grouted? <b>yes</b> With: <input type="checkbox"/> Neat cement <input type="checkbox"/> Bentonite <input checked="" type="checkbox"/> Concrete Depth: From <b>0</b> ft. to <b>10</b> ft.		
			16. Nearest source of possible contamination: ft. <b>1300</b> Direction <b>North</b> Type <b>Barnyard</b> Well disinfected upon completion? <input type="checkbox"/> Yes <input checked="" type="checkbox"/> No		
			17. Pump: <input checked="" type="checkbox"/> Not installed Manufacturer's name _____ Model number _____ HP _____ Volts _____ Length of drop pipe _____ ft. capacity _____ g.p.m. Type: <input type="checkbox"/> Submersible <input type="checkbox"/> Turbine <input type="checkbox"/> Jet <input type="checkbox"/> Reciprocating <input type="checkbox"/> Centrifugal <input type="checkbox"/> Other		
(Use a second sheet if needed)					
18. Elevation:		19. Remarks:		20. Water well contractor's certification: This well was drilled under my jurisdiction and this report is true to the best of my knowledge and belief. <b>Hoobler Drilling Co. 323</b> Business name _____ License No. _____ Address <b>St. Marys, Ks. 66536</b> Signed <b>[Signature]</b> Date <b>1-5-78</b> Authorized representative	
Topography: <input type="checkbox"/> Hill <input type="checkbox"/> Slope <input type="checkbox"/> Upland <input checked="" type="checkbox"/> Valley					

T  
R  
W  
2  
1/4  
1/4  
1/4