


1 LOCATION OF WATER WELL: County: Pottawatomie Fraction: SW 1/4 NW 1/4 NW 1/4 Section Number: 3 Township Number: T 10 S Range Number: R 11 E

Distance and direction from nearest town or city street address of well if located within city?
1/4 mi. W., 1/2 mi. S., & 1/4 mi. E. of Belvue, Ks.

2 WATER WELL OWNER: Kansas Power and Light, Co
 RR#, St. Address, Box #: 818 Kansas Ave. Board of Agriculture, Division of Water Resources
 City, State, ZIP Code: Topeka, Ks. 66601 Application Number: 20,380

3 LOCATE WELL'S LOCATION WITH AN "X" IN SECTION BOX:

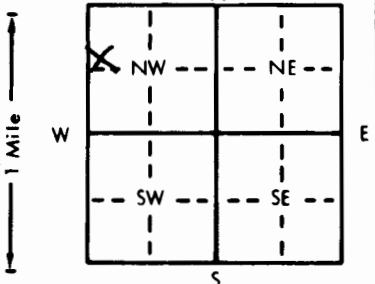

4 DEPTH OF COMPLETED WELL: 65 ft. ELEVATION: 945 ±

Depth(s) Groundwater Encountered 1. 5.2 ft. 2. _____ ft. 3. _____ ft.
 WELL'S STATIC WATER LEVEL 5.0 ft. below land surface measured on mo/day/yr 5/28/82
 Pump test data: Well water was _____ ft. after _____ hours pumping _____ gpm
 Est. Yield 1,100 gpm: Well water was _____ ft. after _____ hours pumping _____ gpm
 Bore Hole Diameter 30 in. to 65 ft., and _____ in. to _____ ft.
 WELL WATER TO BE USED AS:
 1 Domestic 3 Feedlot 6 Oil field water supply 9 Dewatering 11 Injection well
 2 Irrigation 4 Industrial 7 Lawn and garden only 10 Observation well 12 Other (Specify below)
 Was a chemical/bacteriological sample submitted to Department? Yes _____ No X; If yes, mo/day/yr sample was submitted _____
 Water Well Disinfected? Yes _____ No X

5 TYPE OF BLANK CASING USED:
 1 Steel 3 RMP (SR) 5 Wrought iron 8 Concrete tile CASING JOINTS: Glued _____ Clamped _____
 2 PVC 4 ABS 6 Asbestos-Cement 9 Other (specify below) Welded X
 7 Fiberglass Threaded _____

Blank casing diameter 16 in. to 25 ft., Dia _____ in. to _____ ft., Dia _____ in. to _____ ft.
 Casing height above land surface 60 in., weight 24.25 lbs./ft. Wall thickness or gauge No. 188

TYPE OF SCREEN OR PERFORATION MATERIAL:
 1 Steel 3 Stainless steel 5 Fiberglass 7 PVC 10 Asbestos-cement
 2 Brass 4 Galvanized steel 6 Concrete tile 8 RMP (SR) 11 Other (specify) _____
 12 None used (open hole)

SCREEN OR PERFORATION OPENINGS ARE:
 1 Continuous slot 3 Mill slot 5 Gauzed wrapped 8 Saw cut 11 None (open hole)
 2 Louvered shutter 4 Key punched 6 Wire wrapped 9 Drilled holes
 7 Torch cut 10 Other (specify) _____

SCREEN-PERFORATED INTERVALS: From 25 ft. to 65 ft., From _____ ft. to _____ ft.
 From _____ ft. to _____ ft., From _____ ft. to _____ ft.

GRAVEL PACK INTERVALS: From 5 ft. to 65 ft., From _____ ft. to _____ ft.
 From _____ ft. to _____ ft., From _____ ft. to _____ ft.

6 GROUT MATERIAL: 1 Neat cement 2 ~~Cement~~ grout 3 Bentonite 4 Other compacted clay fill
 Grout Intervals: From 0 ft. to 5 ft., From _____ ft. to _____ ft., From _____ ft. to _____ ft.

What is the nearest source of possible contamination:
 1 Septic tank 4 Lateral lines 7 Pit privy 10 Livestock pens 14 Abandoned water well
 2 Sewer lines 5 Cess pool 8 Sewage lagoon 11 Fuel storage 15 Oil well/Gas well
 3 Watertight sewer lines 6 Seepage pit 9 Feedyard 12 Fertilizer storage 16 Other (specify below)
 13 Insecticide storage

Direction from well? Northwest How many feet? 815

| FROM | TO | LITHOLOGIC LOG | FROM | TO | LITHOLOGIC LOG |
|------|----|------------------------------|------|----|----------------|
| 0 | 6 | fill material | | | |
| 6 | 10 | fill material | | | |
| 10 | 18 | coarse sand and gravel. | | | |
| 18 | 22 | gray clay | | | |
| 22 | 32 | coarse gravel | | | |
| 32 | 42 | coarse gravel and sand | | | |
| 42 | 52 | coarse sand. | | | |
| 52 | 65 | coarse yellow sand & gravel. | | | |
| 65 | | shale | | | |

7 CONTRACTOR'S OR LANDOWNER'S CERTIFICATION: This water well was (1) constructed, (2) reconstructed, or (3) plugged under my jurisdiction and was completed on (mo/day/year) 5/27/82 and this record is true to the best of my knowledge and belief. Kansas Water Well Contractor's License No. 429 This Water Well Record was completed on (mo/day/yr) 6/29/82 under the business name of Subgrade Const. by (signature) JH Umbraugh

INSTRUCTIONS: Use typewriter or ball point pen, PLEASE PRESS FIRMLY and PRINT clearly. Please fill in blanks, underline or circle the correct answers. Send top three copies to Kansas Department of Health and Environment, Division of Environment, Environmental Geology Section, Topeka, KS 66620. Send one to WATER WELL OWNER and retain one for your records.

OFFICE USE ONLY T 10 R 11 E SW 1/4 NW 1/4