WATER WELL RECORD Form WWC-5 KSA 82a-1212

1 LOCATION OF WATER WELL:	Fraction	Section Number	Township Number	Range Number
County: Pottawatomie	SW ¼ NW ¼ NW ¼	3	T 10 S	R 11 E/W

Distance and direction from nearest town or city street address of well if located within city?
1/4 mi. W, 1/2 mi. S, & 1/4 mi. E of Belvue, Ks.

2 WATER WELL OWNER: Kansas Power and Light, Co.
RR#, St. Address, Box # : 818 Kansas Avenue
City, State, ZIP Code : Topeka, Ks. 66601

Board of Agriculture, Division of Water Resources
Application Number: 20,380

3 LOCATE WELL'S LOCATION WITH AN "X" IN SECTION BOX:

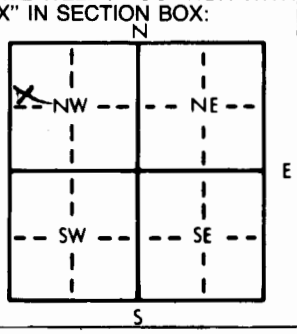

4 DEPTH OF COMPLETED WELL 65 ft. ELEVATION: 945.5
Depth(s) Groundwater Encountered 1. 5.1 ft. 2. ft. 3. ft.
WELL'S STATIC WATER LEVEL 5.0 ft. below land surface measured on mo/day/yr 5/29/82
Pump test data: Well water was ft. after hours pumping gpm
Est. Yield max 1,100 gpm: Well water was ft. after hours pumping gpm
Bore Hole Diameter 30 in. to 65 ft., and in. to ft.
WELL WATER TO BE USED AS: 5 Public water supply 8 Air conditioning 11 Injection well
1 Domestic 3 Feedlot 6 Oil field water supply 9 Dewatering 12 Other (Specify below)
2 Irrigation 4 Industrial 7 Lawn and garden only 10 Observation well
Was a chemical/bacteriological sample submitted to Department? Yes No X; If yes, mo/day/yr sample was submitted
Water Well Disinfected? Yes No X

5 TYPE OF BLANK CASING USED: 5 Wrought iron 8 Concrete tile CASING JOINTS: Glued Clamped
1 Steel 3 RMP (SR) 6 Asbestos-Cement 9 Other (specify below) Welded X
2 PVC 4 ABS 7 Fiberglass Threaded
Blank casing diameter 16 in. to 25 ft., Dia in. to ft., Dia in. to ft.
Casing height above land surface 60 in., weight 24.25 lbs./ft. Wall thickness or gauge No. .188
TYPE OF SCREEN OR PERFORATION MATERIAL: 7 PVC 10 Asbestos-cement
1 Steel 3 Stainless steel 5 Fiberglass 8 RMP (SR) 11 Other (specify)
2 Brass 4 Galvanized steel 6 Concrete tile 9 ABS 12 None used (open hole)
SCREEN OR PERFORATION OPENINGS ARE: 5 Gauzed wrapped 8 Saw cut 11 None (open hole)
1 Continuous slot 3 Mill slot 6 Wire wrapped 9 Drilled holes
2 Louvered shutter 4 Key punched 7 Torch cut 10 Other (specify)
SCREEN-PERFORATED INTERVALS: From 25 ft. to 65 ft., From ft. to ft.
From ft. to ft., From ft. to ft.
GRAVEL PACK INTERVALS: From 5 ft. to 65 ft., From ft. to ft.
From ft. to ft., From ft. to ft.

6 GROUT MATERIAL: 1 Neat cement ~~2 Cement grout~~ 3 Bentonite 4 Other compacted clay fill
Grout Intervals: From 0 ft. to 5 ft., From ft. to ft., From ft. to ft.
What is the nearest source of possible contamination: 10 Livestock pens 14 Abandoned water well
1 Septic tank 4 Lateral lines 7 Pit privy 11 Fuel storage 15 Oil well/Gas well
2 Sewer lines 5 Cess pool 8 Sewage lagoon 12 Fertilizer storage 16 Other (specify below)
3 Watertight sewer lines 6 Seepage pit 9 Feedyard 13 Insecticide storage
Direction from well? North west How many feet? 780 ft.

FROM	TO	LITHOLOGIC LOG	FROM	TO	LITHOLOGIC LOG
0	10	fill material			
10	20	coarse gravel			
20	30	coarse sand & gravel			
30	45	coarse gray sand			
45	55	yellow sand and gravel			
55	65	coarse yellow sand			
65		shale			

7 CONTRACTOR'S OR LANDOWNER'S CERTIFICATION: This water well was (1) constructed, (2) reconstructed, or (3) plugged under my jurisdiction and was completed on (mo/day/year) 5/28/82 and this record is true to the best of my knowledge and belief. Kansas Water Well Contractor's License No. 429 This Water Well Record was completed on (mo/day/yr) 6/29/82 under the business name of Subgrade Construction by (signature) [signature] by [signature]

INSTRUCTIONS: Use typewriter or ball point pen, *PLEASE PRESS FIRMLY* and *PRINT* clearly. Please fill in blanks, underline or circle the correct answers. Send top three copies to Kansas Department of Health and Environment, Division of Environment, Environmental Geology Section, Topeka, KS 66620. Send one to WATER WELL OWNER and retain one for your records.

OFFICE USE ONLY T 10 R 11 E/W SEC. 3 ¼ ¼ ¼ ¼