

1	LOCATION OF WATER WELL: County: <u>Wabunsee</u>	Fraction <u>SE 1/4 SE 1/4 SW 1/4</u>	Section Number <u>17</u>	Township Number <u>10</u>	Range Number <u>11 E</u>
---	--	---	-----------------------------	------------------------------	-----------------------------

Distance and direction from nearest town or city street address of well if located within city?

2 WATER WELL OWNER: John Beatty
 RR#, St. Address, Box #: RR 1 Box 44
 City, State, ZIP Code: Belvue, Ks 66607
 Board of Agriculture, Division of Water Resources
 Application Number:

3 MARK WELL'S LOCATION WITH AN "X" IN SECTION BOX:
N

	N W		N E
W			
	X S W		S E

S

4 DEPTH OF WELL.....18.....ft.
 WELL'S STATIC WATER LEVEL.....6.....ft.
 WELL WAS USED AS:
 1 Domestic 5 Public Water Supply 9 Dewatering
 2 Irrigation 6 Oil Field Water Supply 10 Monitoring Well
 3 Feedlot 7 Lawn and Garden Only 11 Injection Well
 4 Industrial 8 Air Conditioning 12 Other.....
 Was a chemical/bacteriological sample submitted to Department? Yes.....No. X.
 If yes, mo/day/yr sample was submitted.....
 Water Well Disinfected: Yes. X... No.....

5 TYPE OF BLANK CASING USED:
 1 Steel 3 RMP (SR) 5 Wrought 7 Fiberglass 9 Other (specify below)
 2 PVC 4 ABS 6 Asbestos-Cement 8 Concrete Tile

Blank casing diameter.....12.....in. Was casing pulled? Yes..... No. X... If yes, how much.....
 Casing height above or below land surface.....0.....in.

6 GROUT PLUG MATERIAL: 1 Neat cement 2 Cement grout 3 Bentonite 4 Other.....
 Grout Plug Intervals: From 2 1/2 ft. to 3 ft., From.....ft. toft., From..... to.....ft.
 What is the nearest source of possible contamination:
1 Septic tank 6 Seepage pit 11 Fuel storage 16 Other (specify below)
 2 Sewer lines 7 Pit privy 12 Fertilizer storage

3 Watertight sewer lines 8 Sewage lagoon 13 Insecticide storage
 4 Lateral lines 9 Feedyard 14 Abandoned water well
 5 Cess Pool 10 Livestock pens 15 Oil well/Gas well

Direction from well? east How many feet? 70

FROM	TO	PLUGGING MATERIALS

7 CONTRACTOR'S OR LANDOWNER'S CERTIFICATION: This water well was plugged under my jurisdiction and was completed on (mo/day/year) 7/25/78..... and this record is true to the best of my knowledge and belief. Kansas Water Well Contractor's License No. This Water Well Record was completed on (mo/day/year) 7/15/78..... under the business name of Above..... by (signature) John Beatty.....

INSTRUCTIONS: Use typewriter or ball point pen. Please press firmly and print clearly. Please fill in blanks, underline or circle the correct answers. Send top three copies to Kansas Department of Health and Environment, Bureau of Water, Topeka, Kansas 66620-0001. Telephone: 913/296-3565. Send one to Water Well Owner and retain one for your records.

NPS POLLUTION CONTROL FUND
 ABANDONED WATER WELL COST-SHARE PROGRAM
 WELL PLUGGING WORKSHEET

RECEIVED

JUL 20 1998



BUREAU OF WATER

WORKSHEET: (Use water quality bulletin to complete this worksheet, available through Cooperative Extension Service.)

County Wabasha Date _____

Type of Well: Drilled or Hand-Dug (Circle One)

Diameter 12 inches Depth to water 12 ft. Total Depth 18 ft.

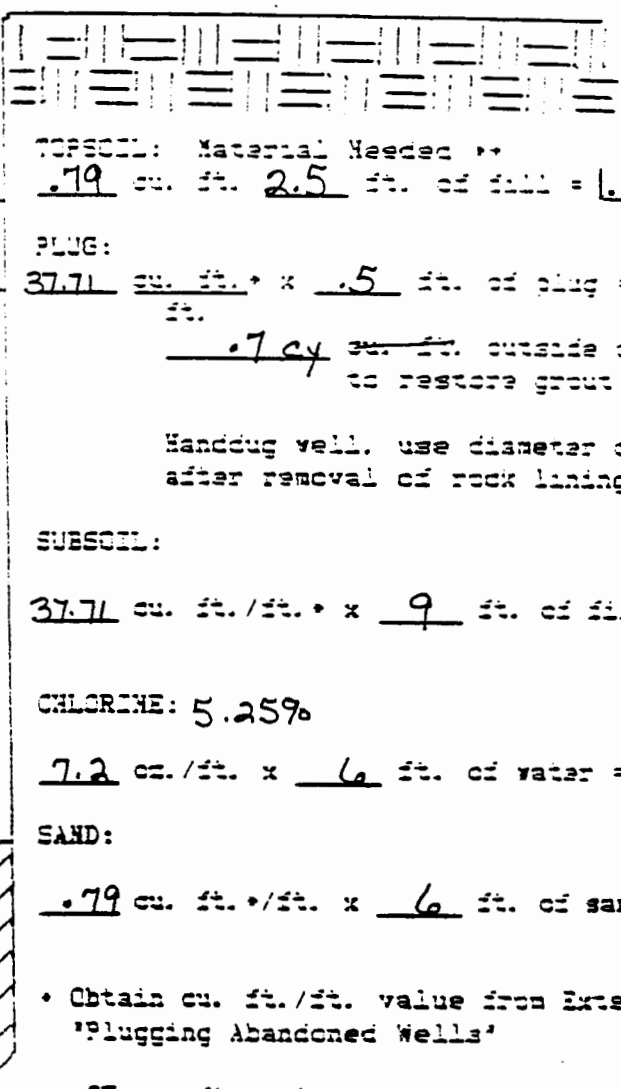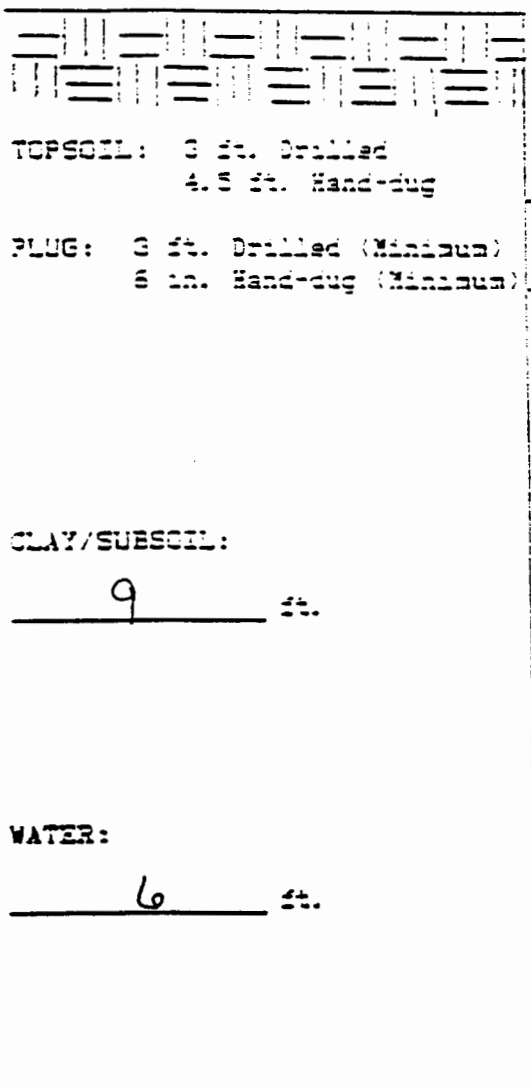

TOPSOIL: 3 ft. Drilled
 4.5 ft. Hand-dug

PLUG: 3 ft. Drilled (Minimum)
 6 in. Hand-dug (Minimum)

CLAY/SUBSOIL:
9 ft.

WATER:
6 ft.

TOPSOIL: Material Needed **
.79 cu. ft. 2.5 ft. of fill = 1.975 cu. ft.
 .073/cy

PLUG:
37.71 cu. ft. * .5 ft. of plug = 18.9 cu. ft. plug
.7 cy cu. ft. outside drilled well to restore grout seal.

Handdug well, use diameter of well after removal of rock lining.

SUBSOIL:
37.71 cu. ft./ft. * 9 ft. of fill = 339.4 cu. ft. subsoil
 12.6/cy

CHLORINE: 5.25%
7.2 oz./ft. * 6 ft. of water = 43.2 Required
 used 2 gallons

SAND:
.79 cu. ft./ft. * 6 ft. of sand = 4.74 cu. ft.
 .174/cy


* Obtain cu. ft./ft. value from Extension Bulletin 'Plugging Abandoned Wells'

** 27 cu. ft. = 1 yard

SITE PREPARATION: REMOVE PUMP AND COLUMN PIPE AND DEBRIS. EXCAVATE AROUND DRILLED WELL CASING AND CUT CASING 3 FEET BELOW GROUND LEVEL. STOCKPILE FILL MATERIAL ON SITE. LEAVE IN TRUCK IF POSSIBLE. HANDDUG WELLS NEED TRACTOR WITH FRONT END LOAD OR LARGE PRY BARS TO CAVE IN ROCK LINING.

**NPS POLLUTION CONTROL FUND
 ABANDONED WATER WELL COST-SHARE PROGRAM
 WELL PLUGGING WORKSHEET (CONTINUED)**

Diagram = 160 acres or quarter section. Below:

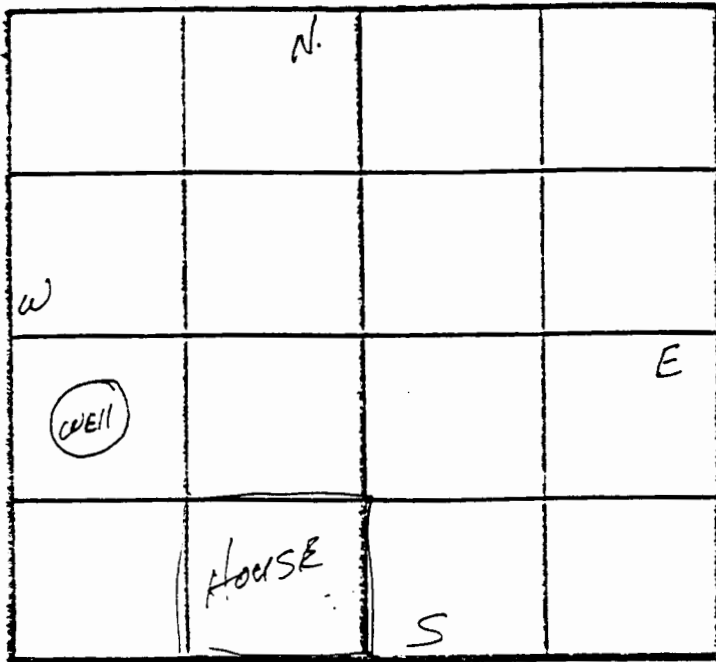

LEGAL DESCRIPTION

_____ 1/4 _____ 1/4 _____ 1/4

Sec. 17 T 10 R 11

LEGEND:

- - Active Well
- Ⓢ - Inactive Well
- X - Abandoned Well

1. Identify tract boundaries and define approximate location of abandoned water wells.

2. Total acres in tract _____.

3. John E. Beatty
 (Landowner Signature)

certifies that all known water wells on this tract have been identified.

SUBMIT ORIGINAL SIGNED COPY WITH NPS-3