

County: Wabaunsee Fraction: SE, SE, SW Sec. 14 T. 10 S R. 11 E

**CORRECTION(S) to WATER WELL COMPLETION RECORD Form WWC-5** (to rectify lacking or incorrect information)

Owner: Daniel Flerlage Windmill

If location corrected, was listed as:

Location changed to:

Section-Township-Range: \_\_\_\_\_

\_\_\_\_\_

Fraction (1/4 calls): Not Reported

SE, SE, SW

Other changes: Initial statements: Final casing height, quarter fractions, & Lat/long not reported.

Changed to: Casing height is -12 ft.

Lat/long (WGS84) (39.173715, -96.157899)

Comments: Since well was in deep pit, no casing was removed. All measurements are from 12 ft below ground surface.

Verification method: Confirmed information and well location with Daniel Flerlage. Also confirmed location with Google Earth, and STR finder.

Initials: BA Date: 08/30/2023

Submitted by: ☐ Kansas Geological Survey, Data Resources Library, 1930 Constant Ave., Lawrence, KS 66047-3724  
☒ Kansas Dept. of Health & Environment, Bureau of Water, 1000 SW Jackson, Suite 420, Topeka, KS 66612-1367

**WATER WELL PLUGGING RECORD Form WWC-5P KSA 82a-1212 ID NO.**

<b>1 LOCATION OF WATER WELL:</b> County: <u>WABAUNSEE</u>	Fraction $\frac{1}{4}$ $\frac{1}{4}$ $\frac{1}{4}$ $\frac{1}{4}$	Section Number <u>14</u>	Township Number <u>10 T S</u>	Range Number <u>11</u> <input type="checkbox"/> E <input type="checkbox"/> W
--	---	-----------------------------	----------------------------------	---

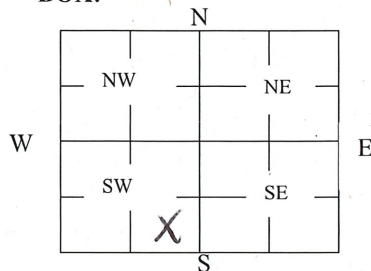
Street/Rural Address of Well Location; if unknown, distance & direction from nearest town or intersection: If at owner's address, check here ☒ 21519 Paxico Rd  
Belvue, KS

**Global Positioning Systems (GPS) information:**

Latitude: \_\_\_\_\_ (in decimal degrees)  
Longitude: \_\_\_\_\_ (in decimal degrees)  
Elevation: \_\_\_\_\_  
Horizontal Datum: ☐ WGS84, ☐ NAD83, ☐ NAD27  
Collection Method: \_\_\_\_\_

**2 WATER WELL OWNER:** Daniel Flerlage  
RR#, St. Address, Box #: 21519 Paxico Rd  
City, State ZIP Code: Belvue, KS 66407

☐ GPS unit (Make/Model: \_\_\_\_\_)  
☐ Digital Map/Photo, ☐ Topographic Map, ☐ Land Survey  
Est. Accuracy: ☐ < 3 m, ☐ 3-5 m, ☐ 5-15 m, ☐ > 15 m

**3 MARK WELL'S LOCATION WITH AN "X" IN SECTION BOX:**

**4 DEPTH OF WELL** 31 **ft.**

WELL'S STATIC WATER LEVEL 27 ft

**WELL WAS USED AS:**

<input checked="" type="checkbox"/> Domestic	<input type="checkbox"/> Public Water Supply	<input type="checkbox"/> Dewatering
<input type="checkbox"/> Irrigation	<input type="checkbox"/> Oil Field Water Supply	<input type="checkbox"/> Monitoring
<input type="checkbox"/> Feedlot	<input type="checkbox"/> Domestic (Lawn & Garden)	<input type="checkbox"/> Injection Well
<input type="checkbox"/> Industrial	<input type="checkbox"/> Air Conditioning	<input type="checkbox"/> Other _____

Was a chemical/bacteriological sample submitted to Department? Yes ☐ No ☒

**5 TYPE OF BLANK CASING USED:**

☒ Steel   ☐ RMP (SR)   ☐ Wrought   ☐ Fiberglass   ☐ Other (Specify below)  
☐ PVC   ☐ ABS   ☐ Asbestos-Cement   ☐ Concrete Tile

Blank casing diameter 1.5 in. Was casing pulled? Yes ☐ No ☒ If yes, how much \_\_\_\_\_  
Casing height above or below land surface \_\_\_\_\_ in.

**6 GROUT PLUG MATERIAL:** ☐ Neat cement   ☒ Cement grout   ☒ Bentonite   ☐ Other \_\_\_\_\_

Grout Plug Intervals: From \_\_\_\_\_ ft. to \_\_\_\_\_ ft., From \_\_\_\_\_ ft. to \_\_\_\_\_ ft., From \_\_\_\_\_ ft. to \_\_\_\_\_ ft.

**What is the nearest source of possible contamination:**

<input type="checkbox"/> Septic tank	<input type="checkbox"/> Seepage pit	<input type="checkbox"/> Fuel storage	<input type="checkbox"/> Other (specify below) _____ Direction from well? _____ How many feet? _____
<input type="checkbox"/> Sewer lines	<input type="checkbox"/> Pit privy	<input type="checkbox"/> Fertilizer storage	
<input type="checkbox"/> Watertight sewer lines	<input type="checkbox"/> Sewage lagoon	<input type="checkbox"/> Insecticide storage	
<input type="checkbox"/> Lateral lines	<input type="checkbox"/> Feedyard	<input type="checkbox"/> Abandoned water well	
<input type="checkbox"/> Cess pool	<input type="checkbox"/> Livestock pens	<input type="checkbox"/> Oil well/Gas well	

FROM	TO	PLUGGING MATERIALS	FROM	TO	PLUGGING MATERIALS
27	31	sand			
6	27	cement grout			
0	6	bentonite			
		bleach 1/2 gal			

**7 CONTRACTOR'S OR LANDOWNER'S CERTIFICATION:** This water well was plugged under my jurisdiction and was completed on (mo/day/year) 04/20/2023 and this record is true to the best of my knowledge and belief. Kansas Water Well Contractor's License No. \_\_\_\_\_. This Water Well Record was completed on (mo/day/year) \_\_\_\_\_ under the business name of \_\_\_\_\_ by (signature) David W. Flerlage

Send one white copy to Kansas Department of Health & Environment, Geology Section, 1000 SW Jackson Street, Ste. 420, Topeka, KS 66612-1367. Send one copy to WATER WELL OWNER and retain one for your records.

Visit us at <http://www.kdheks.gov/waterwell/index.html> Telephone 785-296-5524.