

46

JL R

USE TYPEWRITER OR BALL POINT PEN-PRESS FIRMLY, PRINT CLEARLY.


WATER WELL RECORD
KSA 82a-1201-1215

Kansas Department of Health and Environment-Division of Environment
(Water well Contractors)
Topeka, Kansas 66620

SE
1/4 SW 1/4 NW 1/4 BCD

1. Location of well:	County Wabaunsee	Fraction 300' E. of SW corner of 1/4 Lot 14-7 1/4	Section number 10	Township number T 10S	Range number S R 11 E	E/W
----------------------	----------------------------	---	-----------------------------	---------------------------------	---------------------------------	-----

2. Distance and direction from nearest town or city: 3 1/2 miles SW of Belvue, Kansas	3. Owner of well: Frances B. Royer
Street address of well location if in city:	R.R. or street: 101 West Mission
	City, state, zip code: St. Marys, Kansas 66536

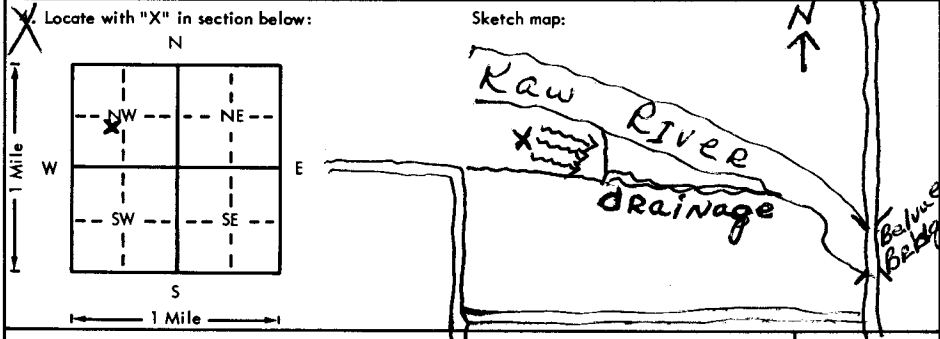

6. Bore hole dia. 32 in. Completion date 1-23-76
Well depth 69 ft.
7. <input type="checkbox"/> Cable tool <input type="checkbox"/> Rotary <input type="checkbox"/> Driven <input type="checkbox"/> Dug <input type="checkbox"/> Hollow rod <input type="checkbox"/> Jetted <input type="checkbox"/> Bored <input checked="" type="checkbox"/> Reverse rotary
8. Use: <input type="checkbox"/> Domestic <input type="checkbox"/> Public supply <input type="checkbox"/> Industry <input checked="" type="checkbox"/> Irrigation <input type="checkbox"/> Air conditioning <input type="checkbox"/> Stock <input type="checkbox"/> Lawn <input type="checkbox"/> Oil field water <input type="checkbox"/> Other
Casing: Material Transite Weight: Above or below
Threaded <input type="checkbox"/> Welded <input type="checkbox"/> Surface 12 in.
RMP <input type="checkbox"/> PVC <input type="checkbox"/> Weight <input type="checkbox"/> lbs./ft.
Dia. 16 in. to 30 ft. depth. Wall thickness: inches or
Dia. <input type="checkbox"/> in. to <input type="checkbox"/> ft. depth. Age No. 25

5. Type and color of material	From	To
Top soil & small sand	0'	12'
Medium Brown	12'	16'
Medium to large green gravel	16'	69'
Large rocks that could not drill through.	69'	69' 6"

9. Screen: Manufacturer's name Johnson
Type Transite Dia. 16"
Slot/gauze 1/8x8" Length 39'
Set between 30' ft. and 69' ft.
Gravel pack? <input checked="" type="checkbox"/> Size range of material 5/8 ft.
11. Static water level: 16 ft. below land surface Date 1-24-76 mo./day/yr.
12. Pumping level below land surfaces: 21 ft. after 1 hrs. pumping 1000 g.p.m. 31 ft. after 3 hrs. pumping 1000 g.p.m. Estimated maximum yield 2500 g.p.m.
13. Water sample submitted: <input type="checkbox"/> Yes <input checked="" type="checkbox"/> No Date
14. Well head completion: no <input type="checkbox"/> Pitless adapter <input type="checkbox"/> Inches above grade
15. Well grouted? yes With: <input type="checkbox"/> Neat cement <input type="checkbox"/> Bentonite <input checked="" type="checkbox"/> Concrete Depth: From 0 ft. to 10 ft.
16. Nearest source of possible contamination: 2500' ft. Direction North Type River Well disinfected upon completion? <input type="checkbox"/> Yes <input checked="" type="checkbox"/> No
17. Pump: <input checked="" type="checkbox"/> Not installed Manufacturer's name _____ Model number _____ HP _____ Volts _____ Length of drop pipe _____ ft. capacity _____ g.p.m. Type: <input type="checkbox"/> Submersible <input type="checkbox"/> Turbine <input type="checkbox"/> Jet <input type="checkbox"/> Reciprocating <input type="checkbox"/> Centrifugal <input type="checkbox"/> Other

18. Elevation: 952	19. Remarks: The hole was tested to 77' but I ran into many large rocks and had to stop at 69'. This well is in River lots.	20. Water well contractor's certification: This well was drilled under my jurisdiction and this report is true to the best of my knowledge and belief. Hoobler Drilling Co. 323 Business name St. Marys, Kans. 66536 Address St. Marys, Kans. 66536 Signed Don Hoobler Date 1-28-76 Authorized representative
---------------------------	--	--

10 11 10 10
W
m
Sec
1/4 1/4 1/4
NESW

Forward the white, blue and pink copies to the Department of Health and Environment

Form WWC-5