


1 LOCATION OF WATER WELL: Fraction SE 1/4 SE 1/4 SE 1/4 Section Number 17 Township Number T 10 S Range Number R 11 E/W
 County: Wabunsee

Distance and direction from nearest town or city street address of well if located within city? From Wamego 60 South on 99 2 miles then 60 East 5 miles on Wills Creek Road & then 200' North

2 WATER WELL OWNER: John Beatie
 RR#, St. Address, Box #: RR#1 Box 18 Board of Agriculture, Division of Water Resources
 City, State, ZIP Code: Bellevue, Kansas 66407 Application Number:

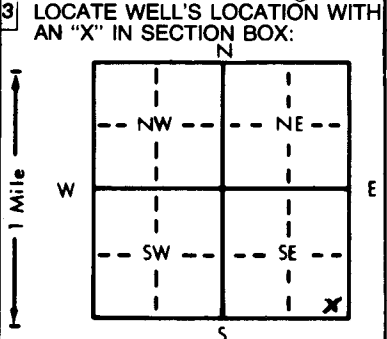

4 DEPTH OF COMPLETED WELL: 60 ft. ELEVATION:
 Depth(s) Groundwater Encountered 1. 25 ft. 2. ft. 3. ft.
 WELL'S STATIC WATER LEVEL 15 ft. below land surface measured on mo/day/yr
 Pump test data: Well water was ft. after hours pumping gpm
 Est. Yield 3 gpm: Well water was ft. after hours pumping gpm
 Bore Hole Diameter: 8 in. to 60 ft., and in. to ft.
 WELL WATER TO BE USED AS:
 1 Domestic 3 Feedlot 6 Oil field water supply 9 Dewatering 12 Other (Specify below)
 2 Irrigation 4 Industrial 7 Lawn and garden only 10 Monitoring well
 Was a chemical/bacteriological sample submitted to Department? Yes.....No.....; If yes, mo/day/yr sample was submitted
 Water Well Disinfected? Yes No

5 TYPE OF BLANK CASING USED:
 1 Steel 3 RMP (SR) 5 Wrought iron 8 Concrete tile CASING JOINTS: Glued Screwed Clamped
 2 PVC 4 ABS 6 Asbestos-Cement 9 Other (specify below) Welded
 7 Fiberglass Threaded
 Blank casing diameter 5 in. to 40 ft., Dia. in. to ft., Dia. in. to ft.
 Casing height above land surface 2 in., weight 56.40 lbs./ft. Wall thickness or gauge No.
 TYPE OF SCREEN OR PERFORATION MATERIAL:
 1 Steel 3 Stainless steel 5 Fiberglass 7 PVC 10 Asbestos-cement
 2 Brass 4 Galvanized steel 6 Concrete tile 9 ABS 11 Other (specify)
 12 None used (open hole)
 SCREEN OR PERFORATION OPENINGS ARE:
 1 Continuous slot 3 Mill slot 3/1000's 5 Gauzed wrapped 8 Saw cut 11 None (open hole)
 2 Louvered shutter 4 Key punched 6 Wire wrapped 9 Drilled holes
 7 Torch cut 10 Other (specify)
 SCREEN-PERFORATED INTERVALS: From 4.0 ft. to 60 ft., From ft. to ft.
 From ft. to ft., From ft. to ft.
 GRAVEL PACK INTERVALS: From 2.0 ft. to 60 ft., From ft. to ft.
 From ft. to ft., From ft. to ft.

6 GROUT MATERIAL: 1 Neat cement 2 Cement grout 3 Bentonite 4 Other
 Grout Intervals: From 0 ft. to 20 ft., From ft. to 5.0 ft., From ft. to ft.
 What is the nearest source of possible contamination:
 1 Septic tank 4 Lateral lines 7 Pit privy 10 Livestock pens 14 Abandoned water well
 2 Sewer lines 5 Cess pool 8 Sewage lagoon 11 Fuel storage 15 Oil well/Gas well
 3 Watertight sewer lines 6 Seepage pit 9 Feedyard 12 Fertilizer storage 16 Other (specify below)
 13 Insecticide storage
 Direction from well? North West How many feet? 180'

FROM	TO	LITHOLOGIC LOG	FROM	TO	PLUGGING INTERVALS
0	3	Top Soil			
3	21	Brown Clay			
21	25	Grey Shale			
25	35	Clay & Gravel (Water)			
35	38	Gravel			
38	52	Grey Shale			
52	54	Rock			
54	60	Grey Shale			

7 CONTRACTOR'S OR LANDOWNER'S CERTIFICATION: This water well was (1) constructed, (2) reconstructed, or (3) plugged under my jurisdiction and was completed on (mo/day/year) 12/13/88 and this record is true to the best of my knowledge and belief. Kansas Water Well Contractor's License No. 45 This Water Well Record was completed on (mo/day/yr) 2/6/89 under the business name of Haldeman Well Drilling by (signature) Craig H.

INSTRUCTIONS: Use typewriter or ball point pen. PLEASE PRESS FIRMLY and PRINT clearly. Please fill in blanks, underline or circle the correct answers. Send top three copies to Kansas Department of Health and Environment, Bureau of Water Protection, Topeka, Kansas 66620-7320. Telephone: 913-296-5514. Send one to WATER WELL OWNER and retain one for your records.