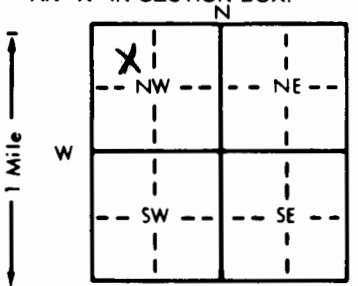


1 LOCATION OF WATER WELL: Fraction $\frac{1}{4}$ N.C. $\frac{1}{4}$ N.W. $\frac{1}{4}$ Section Number 15 Township Number T 10 S Range Number R 12 **EW**
 County: Pott. Distance and direction from nearest town or city street address of well if located within city? From Int. of U.S. 24 and Grand Ave in St. Marys, Ks. $\frac{3}{4}$ mile south and $\frac{1}{4}$ mile west.

2 WATER WELL OWNER: Winifred V. Minnis
 RR#, St. Address, Box #: 602 Main Board of Agriculture, Division of Water Resources
 City, State, ZIP Code: Rossville, Ks, 66533 Application Number: 41,332

3 LOCATE WELL'S LOCATION WITH AN "X" IN SECTION BOX:

 4 DEPTH OF COMPLETED WELL: 41 ft. ELEVATION:
 Depth(s) Groundwater Encountered 1. 18 ft. 2. ft. 3. ft.
 WELL'S STATIC WATER LEVEL: 18 ft. below land surface measured on mo/day/yr 7-28-95
 Pump test data: Well water was 23 ft. after 1 hours pumping 650 gpm
 Est. Yield .750 gpm: Well water was 25 ft. after 1 hours pumping 950 gpm
 Bore Hole Diameter: .32 in. to .41 ft., and in. to ft.
 WELL WATER TO BE USED AS:
 1 Domestic 3 Feedlot 6 Oil field water supply 9 Dewatering 12 Other (Specify below)
 2 Irrigation 4 Industrial 7 Lawn and garden only 10 Monitoring well
 Was a chemical/bacteriological sample submitted to Department? Yes No ; If yes, mo/day/yr sample was submitted
 Water Well Disinfected? Yes No

5 TYPE OF BLANK CASING USED:
 1 Steel 3 RMP (SR) 5 Wrought iron 8 Concrete tile CASING JOINTS: Glued Clamped
 2 PVC 4 ABS 6 Asbestos-Cement 9 Other (specify below) Welded
 7 Fiberglass Threaded
 Blank casing diameter .16 in. to .21 ft., Dia in. to ft., Dia in. to ft.
 Casing height above land surface .12 in., weight lbs./ft. Wall thickness or gauge No. .50
 TYPE OF SCREEN OR PERFORATION MATERIAL:
 1 Steel 3 Stainless steel 5 Fiberglass 7 PVC 10 Asbestos-cement
 2 Brass 4 Galvanized steel 6 Concrete tile 8 RMP (SR) 11 Other (specify)
 9 ABS 12 None used (open hole)
 SCREEN OR PERFORATION OPENINGS ARE:
 1 Continuous slot 3 Mill slot 5 Gauzed wrapped 8 Saw cut 11 None (open hole)
 2 Louvered shutter 4 Key punched 6 Wire wrapped 9 Drilled holes
 7 Torch cut 10 Other (specify)
 SCREEN-PERFORATED INTERVALS: From 21 ft. to 41 ft., From ft. to ft.
 GRAVEL PACK INTERVALS: From 20 ft. to 41 ft., From ft. to ft.

6 GROUT MATERIAL: 1 Neat cement 2 Cement grout 3 Bentonite 4 Other
 Grout Intervals: From 0 ft. to 20 ft., From ft. to ft., From ft. to ft.
 What is the nearest source of possible contamination:
 1 Septic tank 4 Lateral lines 7 Pit privy 10 Livestock pens 14 Abandoned water well
 2 Sewer lines 5 Cess pool 8 Sewage lagoon 11 Fuel storage 15 Oil well/Gas well
 3 Watertight sewer lines 6 Seepage pit 9 Feedyard 12 Fertilizer storage 16 Other (specify below)
 13 Insecticide storage none
 Direction from well? How many feet?

FROM	TO	LITHOLOGIC LOG	FROM	TO	PLUGGING INTERVALS
0	7	Brown sandy silt			
7	16	Fine brown sand			
16	19	Small-medium brown gravel			
19	21	Medium-large grey gravel			
21	30	Fine grey sand			
30	32	Medium grey gravel			
32	35	Medium-large grey gravel			
35	39	Medium grey gravel and grey clay			
39	41	Medium-large grey gravel			
	41	Weathered shale, stopped			

7 CONTRACTOR'S OR LANDOWNER'S CERTIFICATION: This water well was (1) constructed, (2) reconstructed, or (3) plugged under my jurisdiction and was completed on (mo/day/year) 7-28-95 and this record is true to the best of my knowledge and belief. Kansas Water Well Contractor's License No. 323 This Water Well Record was completed on (mo/day/yr) 8-29-95 under the business name of Hoobler Drilling Co. by (signature) *Don Hoobler*