


WATER WELL RECORD Form WWC-5 KSA 82a-1212

1 LOCATION OF WATER WELL: County: Pott Fraction: NE 1/4 NE 1/4 NW 1/4 Section Number: 14 Township Number: T 10 S Range Number: R 12 E/W

Distance and direction from nearest town or city street address of well if located within city? From ST MARYS 60 1/4 MILE EAST on 24 Highway + 1/4 South

2 WATER WELL OWNER: MIKE WILTZ  
RR#, St. Address, Box #: 2755 GARBIT DRIVE Board of Agriculture, Division of Water Resources  
City, State, ZIP Code: ST MARYS, KS Application Number:

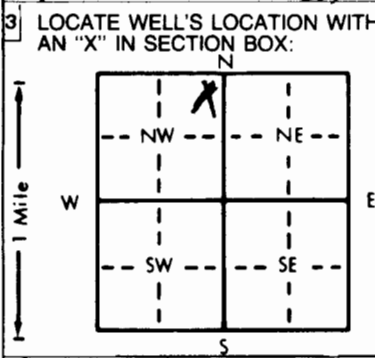

4 DEPTH OF COMPLETED WELL: 47 ft. ELEVATION:  
Depth(s) Groundwater Encountered: 1. 22 ft. 2. \_\_\_\_\_ ft. 3. \_\_\_\_\_ ft.  
WELL'S STATIC WATER LEVEL: 20 ft. below land surface measured on mo/day/yr  
Pump test data: Well water was \_\_\_\_\_ ft. after \_\_\_\_\_ hours pumping \_\_\_\_\_ gpm  
Est. Yield: 50 gpm: Well water was \_\_\_\_\_ ft. after \_\_\_\_\_ hours pumping \_\_\_\_\_ gpm  
Bore Hole Diameter: 10 in. to 4.7 ft., and \_\_\_\_\_ in. to \_\_\_\_\_ ft.  
WELL WATER TO BE USED AS:  
 1 Domestic  3 Feedlot  6 Oil field water supply  9 Dewatering  12 Other (Specify below)  
 2 Irrigation  4 Industrial  7 Lawn and garden only  10 Monitoring well  
Was a chemical/bacteriological sample submitted to Department? Yes \_\_\_\_\_ No \_\_\_\_\_ If yes, mo/day/yr sample was submitted \_\_\_\_\_  
Water Well Disinfected:  Yes  No

5 TYPE OF BLANK CASING USED:  
1 Steel  3 RMP (SR)  5 Wrought iron  8 Concrete tile  CASING JOINTS:  Gued  Clamped  
 2 PVC  4 ABS  7 Fiberglass  9 Other (specify below)  Welded  
Blank casing diameter: 5 in. to 27 ft., Dia \_\_\_\_\_ in. to \_\_\_\_\_ ft., Dia \_\_\_\_\_ in. to \_\_\_\_\_ ft.  
Casing height above land surface: 2 in., weight 2440 lbs./ft. Wall thickness or gauge No. \_\_\_\_\_  
TYPE OF SCREEN OR PERFORATION MATERIAL:  
1 Steel  3 Stainless steel  5 Fiberglass  8 RMP (SR)  10 Asbestos-cement  
2 Brass  4 Galvanized steel  6 Concrete tile  9 ABS  11 Other (specify) \_\_\_\_\_  
12 None used (open hole)  
SCREEN OR PERFORATION OPENINGS ARE:  
1 Continuous slot  3 Mill slot  10/3000 5 Gauzed wrapped  8 Saw cut  11 None (open hole)  
2 Louvered shutter  4 Key punched  6 Wire wrapped  9 Drilled holes   
7 Torch cut  10 Other (specify) \_\_\_\_\_  
SCREEN-PERFORATED INTERVALS: From 27 ft. to 47 ft., From \_\_\_\_\_ ft. to \_\_\_\_\_ ft.  
GRAVEL PACK INTERVALS: From 25 ft. to 47 ft., From \_\_\_\_\_ ft. to \_\_\_\_\_ ft.

6 GROUT MATERIAL: 1 Neat cement  2 Cement grout  3 Bentonite  4 Other \_\_\_\_\_  
Grout Intervals: From 0 ft. to 25 ft., From \_\_\_\_\_ ft. to \_\_\_\_\_ ft., From \_\_\_\_\_ ft. to \_\_\_\_\_ ft.  
What is the nearest source of possible contamination:  
1 Septic tank  4 Lateral lines  7 Pit privy  10 Livestock pens  14 Abandoned water well  
2 Sewer lines  5 Cess pool  8 Sewage lagoon  11 Fuel storage  15 Oil well/Gas well  
3 Watertight sewer lines  6 Seepage pit  9 Feedyard  12 Fertilizer storage  16 Other (specify below)  
13 Insecticide storage  
Direction from well? S.E. How many feet? 250

FROM	TO	LITHOLOGIC LOG	FROM	TO	PLUGGING INTERVALS
<u>0</u>	<u>2</u>	<u>Top Soil</u>			
<u>2</u>	<u>22</u>	<u>Brown Clay</u>			
<u>22</u>	<u>28</u>	<u>Sandy Clay (Water)</u>			
<u>28</u>	<u>47</u>	<u>Medium Sand</u>			

7 CONTRACTOR'S OR LANDOWNER'S CERTIFICATION: This water well was  (1) constructed,  (2) reconstructed, or  (3) plugged under my jurisdiction and was completed on (mo/day/year) 9/14/96 and this record is true to the best of my knowledge and belief. Kansas Water Well Contractor's License No. 451 This Water Well Record was completed on (mo/day/yr) 10/14/96 under the business name of Holdeman Well Drilling by (signature) Craig A. Cupst

INSTRUCTIONS: Use typewriter or ball point pen. PLEASE PRESS FIRMLY and PRINT clearly. Please fill in blanks, underline or circle the correct answers. Send top three copies to Kansas Department of Health and Environment, Bureau of Water, Topeka, Kansas 66620-0001. Telephone: 913-296-5545. Send one to WATER WELL OWNER and retain one for your records.