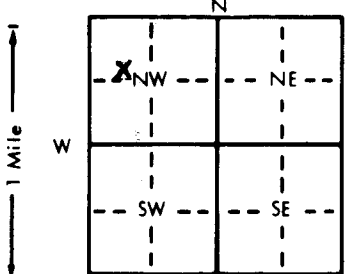


1 LOCATION OF WATER WELL:		Fraction	Section Number	Township Number	Range Number
County: POTT.		N. C. W OF W. $\frac{1}{2}$ $\frac{1}{4}$ NW $\frac{1}{4}$	7	T 10 S	R 12 E XX
Distance and direction from nearest town or city street address of well if located within city?					
TWO MILES WEST OF ST. MARYS					
2 WATER WELL OWNER: PESSIMIER CO. C/O CHRISTIAN ROYER					
RR#, St. Address, Box #: BOX 206			Board of Agriculture, Division of Water Resources		
City, State, ZIP Code: ST MARYS KS 66536			Application Number: 3752 & 28009		
3 LOCATE WELL'S LOCATION WITH AN "X" IN SECTION BOX:		4 DEPTH OF COMPLETED WELL: 64 ft. ELEVATION:			
		Depth(s) Groundwater Encountered 1. 17' ft. 2. ft. 3. ft.			
		WELL'S STATIC WATER LEVEL 17 ft. below land surface measured on mo/day/yr			
		Pump test data: Well water was 28 ft. after 1 hours pumping 850 gpm			
		Est. Yield 1500 gpm: Well water was 29 ft. after 1 hours pumping 950 gpm			
		Bore Hole Diameter 32 in. to ft., and in. to ft.			
		WELL WATER TO BE USED AS:			
		5 Public water supply 8 Air conditioning 11 Injection well			
		1 Domestic 3 Feedlot 6 Oil field water supply 9 Dewatering 12 Other (Specify below)			
		2 Irrigation 4 Industrial 7 Lawn and garden only 10 Monitoring well			
		Was a chemical/bacteriological sample submitted to Department? Yes No XX; If yes, mo/day/yr sample was submitted			
		Water Well Disinfected? Yes No XX			
5 TYPE OF BLANK CASING USED:					
1 Steel 3 RMP (SR) 5 Wrought iron 8 Concrete tile CASING JOINTS: Glued XX Clamped XX					
2 PVC 4 ABS 6 Asbestos-Cement 9 Other (specify below) Welded					
Blank casing diameter 16 in. to 44 ft., Dia in. to ft., Dia in. to ft.					
Casing height above land surface 12 in., weight lbs./ft. Wall thickness or gauge No. 50					
TYPE OF SCREEN OR PERFORATION MATERIAL:					
1 Steel 3 Stainless steel 5 Fiberglass 7 PVC 10 Asbestos-cement					
2 Brass 4 Galvanized steel 6 Concrete tile 8 RMP (SR) 11 Other (specify)					
3 None used (open hole)					
SCREEN OR PERFORATION OPENINGS ARE:					
1 Continuous slot 5 Gauzed wrapped 8 Saw cut 11 None (open hole)					
2 Louvered shutter 3 Mill slot 6 Wire wrapped 9 Drilled holes					
4 Key punched 7 Torch cut 10 Other (specify)					
SCREEN-PERFORATED INTERVALS: From 44 ft. to 64 ft., From ft. to ft.					
From ft. to ft., From ft. to ft.					
GRAVEL PACK INTERVALS: From 20 ft. to 64 ft., From ft. to ft.					
From ft. to ft., From ft. to ft.					
6 GROUT MATERIAL: 1 Neat cement 2 Cement grout 3 Bentonite 4 Other					
Grout Intervals: From 0 ft. to 20 ft., From ft. to ft., From ft. to ft.					
What is the nearest source of possible contamination:					
1 Septic tank 4 Lateral lines 7 Pit privy 10 Livestock pens 14 Abandoned water well					
2 Sewer lines 5 Cess pool 8 Sewage lagoon 11 Fuel storage 15 Oil well/Gas well					
3 Watertight sewer lines 6 Seepage pit 9 Feedyard 12 Fertilizer storage 16 Other (specify below)					
13 Insecticide storage					
Direction from well? NORTH How many feet? 15					
FROM		TO		LITHOLOGIC LOG	
FROM		TO		PLUGGING INTERVALS	
0		1		BLACK TOP SOIL	
1		4		BROWN SANDY SILT	
4		21		FINE BROWN SAND	
21		30		SMALL-MEDIUM BROWN SAND	
30		32		MEDIUM-LARGE GREY GRAVEL & GREY CLAY	
32		59		MEDIUM-LARGE BROWN GRAVEL	
59		60		FINE GREY SAND	
60		64		MEDIUM-LARGE GREY GRAVEL	
		64		WEATHERED SHALE, STOPPED	
7 CONTRACTOR'S OR LANDOWNER'S CERTIFICATION: This water well was (1) constructed, (2) reconstructed, or (3) plugged under my jurisdiction and was completed on (mo/day/year) 4-9-97 and this record is true to the best of my knowledge and belief. Kansas Water Well Contractor's License No. 323 This Water Well Record was completed on (mo/day/yr) 5-2-97 under the business name of HOOBLER DRILLING CO. by (signature) [Signature]					
INSTRUCTIONS: Use typewriter or ball point pen. PLEASE PRESS FIRMLY and PRINT clearly. Please fill in blanks, underline or circle the correct answers. Send top three copies to Kansas Department of Health and Environment, Bureau of Water, Topeka, Kansas 66620-0001. Telephone: 913-296-5545. Send one to WATER WELL OWNER and retain one for your records.					