


1 LOCATION OF WATER WELL: Fraction S 1/4 NW 1/4 SW 1/4 Section Number 33 Township Number T 10 S Range Number R 12 W  
 County: WABE AUNSEL  
 Distance and direction from nearest town or city street address of well if located within city? To Turkey Creek Rd & then go west 4 miles From Maple Hill go south 3 miles

2 WATER WELL OWNER: ROBERT J. AWITKAMP  
 RR#, St. Address, Box #: RR #1 Box 105 Board of Agriculture, Division of Water Resources  
 City, State, ZIP Code: MAPLE HILL, KS 66507 Application Number:

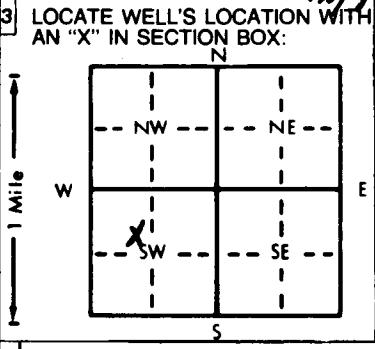

4 DEPTH OF COMPLETED WELL: 40' ft. ELEVATION:  
 Depth(s) Groundwater Encountered 1. 19 ft. 2. ft. 3. ft.  
 WELL'S STATIC WATER LEVEL 19 ft. below land surface measured on mo/day/yr  
 Pump test data: Well water was ft. after hours pumping gpm  
 Est. Yield 1.2 gpm: Well water was ft. after hours pumping gpm  
 Bore Hole Diameter 10 in. to 40 ft., and in. to ft.  
 WELL WATER TO BE USED AS: 5 Public water supply 8 Air conditioning 11 Injection well  
 1 Domestic 3 Feedlot 6 Oil field water supply 9 Dewatering 12 Other (Specify below)  
 2 Irrigation 4 Industrial 7 Lawn and garden only 10 Monitoring well  
 Was a chemical/bacteriological sample submitted to Department? Yes No If yes, mo/day/yr sample was submitted  
 Water Well Disinfected  Yes No

5 TYPE OF BLANK CASING USED:  
 1 Steel  3 RMP (SR)  5 Wrought iron  8 Concrete tile CASING JOINTS:  Glued  Clamped  
 2 PVC  4 ABS  6 Asbestos-Cement  9 Other (specify below)  Welded  
 7 Fiberglass  Threaded  
 Blank casing diameter 5 in. to 20 ft., Dia. in. to ft., Dia. in. to ft.  
 Casing height above land surface 2 in., weight Sch 40 lbs./ft. Wall thickness or gauge No.  
 TYPE OF SCREEN OR PERFORATION MATERIAL:  
 1 Steel  3 Stainless steel  5 Fiberglass  7 PVC  10 Asbestos-cement  
 2 Brass  4 Galvanized steel  6 Concrete tile  9 ABS  11 Other (specify)  
 SCREEN OR PERFORATION OPENINGS ARE: 10/1000's  5 Gauzed wrapped  8 Saw cut  11 None (open hole)  
 1 Continuous slot  3 Mill slot  6 Wire wrapped  9 Drilled holes  
 2 Louvered shutter  4 Key punched  7 Torch cut  10 Other (specify)  
 SCREEN-PERFORATED INTERVALS: From 20 ft. to 40 ft., From ft. to ft.  
 GRAVEL PACK INTERVALS: From 20 ft. to 40 ft., From ft. to ft.  
 From ft. to ft., From ft. to ft.

6 GROUT MATERIAL:  1 Neat cement  2 Cement grout  3 Bentonite  4 Other  
 Grout Intervals: From 0 ft. to 20 ft., From ft. to ft.  
 What is the nearest source of possible contamination: None Close  
 1 Septic tank  4 Lateral lines  Pit privy  10 Livestock pens  14 Abandoned water well  
 2 Sewer lines  5 Cess pool  8 Sewage lagoon  11 Fuel storage  15 Oil well/Gas well  
 3 Watertight sewer lines  6 Seepage pit  9 Feedyard  12 Fertilizer storage  16 Other (specify below)  
 13 Insecticide storage  
 Direction from well? How many feet?

FROM	TO	LITHOLOGIC LOG	FROM	TO	PLUGGING INTERVALS
0	1	Top Soil			
1	5	Brown clay			
5	6	limestone			
6	19	Brown Clay			
19	27	Gravel (Water)			
27	40	Grey Shale			

7 CONTRACTOR'S OR LANDOWNER'S CERTIFICATION: This water well was  (1) constructed,  (2) reconstructed, or  (3) plugged under my jurisdiction and was completed on (mo/day/year) 3/23/99 and this record is true to the best of my knowledge and belief. Kansas Water Well Contractor's License No. 451 This Water Well Record was completed on (mo/day/yr) 4/18/99 under the business name of Haldeman Well Drilling by (signature) Craig W. CWP/PT