

WATER WELL RECORD Form WWC-5 KSA 82a-1212


1 LOCATION OF WATER WELL: Fraction NEAR CENTER OF $\frac{1}{4}$ SE $\frac{1}{4}$ Section Number 19 Township Number T 10 S Range Number R 12 EW
 County: WABAUNSEE

Distance and direction from nearest town or city street address of well if located within city?

2 MILES WEST & 2 MILES SOUTH OF ST. MARYS KANSAS

2 WATER WELL OWNER: ~~JOHN ROBERT FALLEY XXXX~~ BERT FALLEY
 RR#, St. Address, Box #: ~~XXXXXX XXXX XXXX XXXX XXXX~~ 1632 NW GROVE AVE Board of Agriculture, Division of Water Resources
 City, State, ZIP Code: ~~MARIE XXXX XXXX KANSAS XXXX XXXX~~ TOPEKA KS 66606 Application Number: 45338

3 LOCATE WELL'S LOCATION WITH AN "X" IN SECTION BOX:

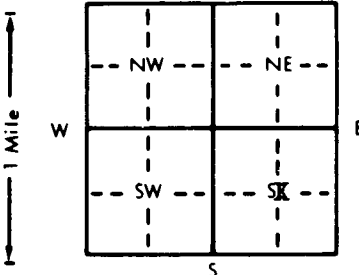

4 DEPTH OF COMPLETED WELL: 81 ft. ELEVATION:
 Depth(s) Groundwater Encountered 1. 29 ft. 2. ft. 3. ft.
 WELL'S STATIC WATER LEVEL: 29 ft. below land surface measured on mo/day/yr 6-18-03
 Pump test data: Well water was 32 ft. after 1 hours pumping 800 gpm
 Est. Yield 1500 gpm: Well water was 35 ft. after 2 hours pumping 1200 gpm
 Bore Hole Diameter: 32 in. to 81 ft., and in. to ft.
 WELL WATER TO BE USED AS: 5 Public water supply 8 Air conditioning 11 Injection well
 1 Domestic 3 Feedlot 6 Oil field water supply 9 Dewatering 12 Other (Specify below)
 2 Irrigation 4 Industrial 7 Lawn and garden only 10 Monitoring well
 Was a chemical/bacteriological sample submitted to Department? Yes No X; If yes, mo/day/yr sample was submitted
 Water Well Disinfected? Yes No X

5 TYPE OF BLANK CASING USED: 5 Wrought iron 8 Concrete tile CASING JOINTS: Glued X Clamped X
 1 Steel 3 RMP (SR) 6 Asbestos-Cement 9 Other (specify below) Welded
 2 PVC 4 ABS 7 Fiberglass Threaded
 Blank casing diameter 16 in. to 41 ft., Dia. in. to ft., Dia. in. to ft.
 Casing height above land surface 12 in., weight lbs./ft. Wall thickness or gauge No. .50
 TYPE OF SCREEN OR PERFORATION MATERIAL: 7 PVC 10 Asbestos-cement
 1 Steel 3 Stainless steel 5 Fiberglass 8 RMP (SR) 11 Other (specify)
 2 Brass 4 Galvanized steel 6 Concrete tile 9 ABS 12 None used (open hole)
 SCREEN OR PERFORATION OPENINGS ARE: 5 Gauzed wrapped 8 Saw cut 11 None (open hole)
 1 Continuous slot 3 Mill slot 6 Wire wrapped 9 Drilled holes
 2 Louvered shutter 4 Key punched 7 Torch cut 10 Other (specify)
 SCREEN-PERFORATED INTERVALS: From 41 ft. to 81 ft., From ft. to ft.
 GRAVEL PACK INTERVALS: From 20 ft. to 81 ft., From ft. to ft.

6 GROUT MATERIAL: 1 Neat cement 2 Cement grout 3 Bentonite 4 Other
 Grout Intervals: From 0 ft. to 20 ft., From ft. to ft., From ft. to ft.
 What is the nearest source of possible contamination:
 1 Septic tank 4 Lateral lines 7 Pit privy 10 Livestock pens 14 Abandoned water well
 2 Sewer lines 5 Cess pool 8 Sewage lagoon 11 Fuel storage 15 Oil well/Gas well
 3 Watertight sewer lines 6 Seepage pit 9 Feedyard 12 Fertilizer storage 16 Other (specify below)
 NONE
 Direction from well? How many feet?

FROM	TO	LITHOLOGIC LOG	FROM	TO	PLUGGING INTERVALS
0	2	BLACK TOP SOIL			
2	26	BROWN & GREY CLAYS			
26	30	FINE GREY SAND & GREY CLAY			
30	38	FINE GREY SAND			
38	42	SMALL-MEDIUM GREY GRAVEL			
42	57	MEDIUM-LARGE GREY GRAVEL			
57	59	MEDIUM-LARGE GREY GRAVEL & GREY CLAY			
59	68	SMALL-MEDIUM GREY GRAVEL			
68	81	MEDIUM-LARGE GREY GRAVEL & SMALL COBBLES			
	81	COBBLES , STOPPED			

7 CONTRACTOR'S OR LANDOWNER'S CERTIFICATION: This water well was (1) constructed, (2) reconstructed, or (3) plugged under my jurisdiction and was completed on (mo/day/year) 6-19-03 and this record is true to the best of my knowledge and belief. Kansas Water Well Contractor's License No. 323 This Water Well Record was completed on (mo/day/yr) 6-29-03 under the business name of HOUBLER DRILLING CO. by (signature)

INSTRUCTIONS: Use typewriter or ball point pen. PLEASE PRESS FIRMLY and PRINT clearly. Please fill in blanks, underline or circle the correct answers. Send top three copies to Kansas Department of Health and Environment, Bureau of Water, Topeka, Kansas 66620-0001. Telephone: 913-296-5545. Send one to WATER WELL OWNER and retain one for your records.

OFFICE USE ONLY
T
R
EW
SEC
1/4
1/4
1/4