

WATER WELL RECORD

located - Top Kan 20-12dd
no map location
 Entered in computer file
 BRT

DRILLERS LOG OF WELL

FROM (FT.)	TO (FT.)	KIND OF MATERIAL, COLOR, ETC. (NOTE WATER ZONES, AMOUNT, QUALITY)
0	8	TOPSOIL & CLAY
8	27	LIME
27	31	SHALE, BLACK
31	33	LIME, (HD)
33	45	SHALE, GRAY
45	53	LIME
53	74	SHALE, GRAY
74	79	SHALE, RED
79	88	SHALE, GRAY
88	106	SANDSTONE (WATER)
106	109	SHALE
109	110	COAL
110	150	SHALE, GRAY, SANDY
150	TD	

Well Owner CLYDE DONAUVON
 Address R R 3 LEAVENWORTH
 Drilling Contractor W.L. HENDEE, JR.
MUNCIE, KANSAS
 Date Drilled 4/26/56 - 5/4/56
 Method of Drilling CABLE
 Casing: 120' - 5 1/2" X 100 LB PLAIN
(New, Used—Steel, Galv.—Gage or Weight)
 Casing Schedule: 30' - 3" X 100 PERF
(Amount, Size, Setting)
GRAVEL PACKED
 Screen Data (if any): _____

ON COMPLETED WELL

Measured depth to water (Static Level) is 890 ft.
 below LAND SURFACE
(Land Surface, Top of Casing, Etc.)
 TESTED YIELD: 40 gallons per 1 HOUR
(Min., Hour)
 as determined by BAILING
(Bailing, Test Pumping, Etc.)
 DRAWDOWN: _____ ft. after _____ hrs.
 pumping at _____ gal. per minute.

REMARKS:

*TOP Kan Study
MAP*


BR-992

*1070
9/10 SW*

DDD

3 mi. W. - 1/2 mi. S. - JARBAL

LOCATION OF WELL
 [Show location in Section Plat] Elev. 1000

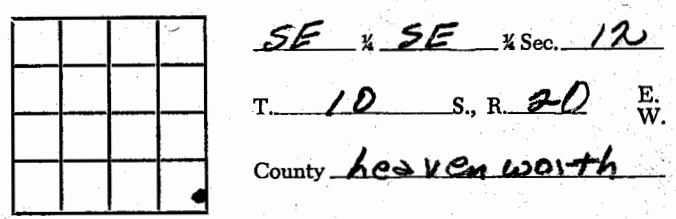

"To preserve water well information and to promote the conservation, protection, and development of ground-water resources."

P