WATER WELL RECORD Form WWC-5 KSA 82a-1212 ID No. _____

1 LOCATION OF WATER WELL:	Fraction	Section Number	Township Number	Range Number
County: **Pottawatomie**	**NW** ¼ **SE** ¼ **NE** ¼	**22**	T **10** S	R **12** (E) W

Distance and direction from nearest town or city street address of well if located within city?

2 WATER WELL OWNER: **MCM Properties LLC**
RR#, St. Address, Box # : **PO Box 668**
City, State, ZIP Code : **Manhattan, KS 66505**

Board of Agriculture, Division of Water Resources
Application Number: **42,146**

3 LOCATE WELL'S LOCATON WITH AN "X" IN SECTION BOX:

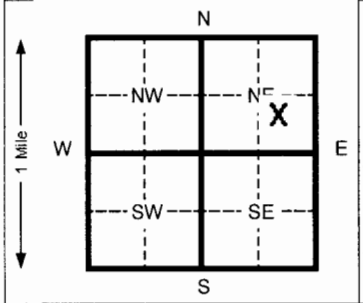

4 DEPTH OF COMPLETED WELL **80** ft. ELEVATION: _____

Depth(s) Groundwater Encountered 1 _____ ft. 2 _____ ft. 3 _____ ft.

WELL'S STATIC WATER LEVEL _____ ft. below land surface measured on mo/day/yr _____

Pump test data: Well water was _____ ft. after _____ hours pumping _____ gpm

Est. Yield _____ gpm: Well water was _____ ft. after _____ hours pumping _____ gpm

Bore Hole Diameter **30** in. to **80** ft. and _____ in. to _____ ft.

WELL WATER TO BE USED AS: 5 Public water supply 8 Air conditioning 11 Injection well
(1) Domestic 3 Feed lot 6 Oil field water supply 9 Dewatering 12 Other (Specify below)
(2) Irrigation 4 Industrial 7 Lawn and garden (domestic) 10 Monitoring well

Was a chemical/bacteriological sample submitted to Department? Yes _____ No **X** If yes, mo/day/yr sample was submitted _____ Water Well Disinfected? Yes **X** No

5 TYPE OF BLANK CASING USED: 5 Wrought Iron 8 Concrete tile CASING JOINTS: Glued **X** Clamped _____
1 Steel 3 RMP (SR) 6 Asbestos-Cement 9 Other (specify below) Welded _____
(2) PVC 4 ABS 7 Fiberglass _____ Threaded _____

Blank casing diameter **16** in. to **80** ft., Dia _____ in. to _____ ft., Dia _____ in. to _____ ft.

Casing height above land surface **24** in., weight **16.150** lbs./ft. Wall thickness or gauge No. **.500**

TYPE OF SCREEN OR PERFORATION MATERIAL: (7) PVC 10 Asbestos-cement
1 Steel 3 Stainless steel 5 Fiberglass 8 RMP (SR) 11 Other (specify) _____
2 Brass 4 Galvanized steel 6 Concrete tile 9 ABS 12 None used (open hole)

SCREEN OR PERFORATION OPENINGS ARE: 5 Gauzed wrapped (8) Saw cut 11 None (open hole)
1 Continuous slot 3 Mill slot 6 Wire wrapped 9 Drilled holes
2 Louvered shutter 4 Key punched 7 Torch cut 10 Other (specify) _____

SCREEN-PERFORATED INTERVALS: From **40** ft. to **80** ft. From _____ ft. to _____ ft.
From _____ ft. to _____ ft. From _____ ft. to _____ ft.

GRAVEL PACK INTERVALS: From **20** ft. to **80** ft. From _____ ft. to _____ ft.
From _____ ft. to _____ ft. From _____ ft. to _____ ft.

6 GROUT MATERIAL: 1 Neat cement (2) Cement grout 3 Bentonite 4 Other _____

Grout Intervals From **0** ft. to **20** ft. From _____ ft. to _____ ft. From _____ ft. to _____ ft.

What is the nearest source of possible contamination: 10 Livestock pens 14 Abandoned water well
1 Septic tank 4 Lateral lines 7 Pit privy 11 Fuel storage 15 Oil well/ Gas well
2 Sewer lines 5 Cess pool 8 Sewage lagoon 12 Fertilizer storage (16) Other (specify below)
3 Watertight sewer lines 6 Seepage pit 9 Feedyard 13 Insecticide storage **none**

Direction from well? How many feet?

FROM	TO	CODE	LITHOLOGIC LOG	FROM	TO	PLUGGING INTERVALS
0	2		Surface			
2	10		Silty Clay & fine sand			
10	18		Fine to some med sand w/clay			
			Str			
18	40		Fine to med sand & gravel			
40	79		Fine to med sand & gravel w/			
			Cobbles str			
79	80		Black Shale			

7 CONTRACTOR'S OR LANDOWNER'S CERTIFICATION: This water well was (1) constructed, (2) reconstructed, or (3) plugged under my jurisdiction and was completed on (mo/day/yr) **3/3/09** and this record is true to the best of my knowledge and belief. Kansas Water Well Contractor's License No. **554** This Water Well Record was completed on (mo/day/yr) **4/3/09** under the business name of **Woofter Pump & Well Inc.** by (signature) [signature]

INSTRUCTIONS:. Please fill in blanks and circle the correct answers. Send three copies to Kansas Department of Health and Environment, Bureau of Water, 1000 S W Jackson St., Ste. 420, Topeka, Kansas 66612-1367. Telephone: 913-296-5545. Send one to WATER WELL OWNER and retain one for your records.

OFFICE USE ONLY T R SEC

White CopyForm provided by Forms-On-A-Disk, Inc. · Dallas, Texas · (214) 340-9429