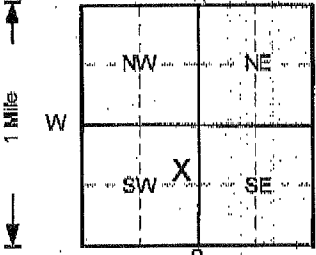


1 LOCATION OF WATER WELL: County: Pottawatomie		Fraction SE ¼ NE ¼ SW ¼			Section Number 10		Township Number T 10 S		Range Number R 12 E/W	
Distance and direction from nearest town or city street address of well if located within city? 103 W. Bertrand, St. Marys							Lat. 39.19158 Long. 96.06394			
2 WATER WELL OWNER: St. Marys Standard Service RR#, St. Address, Box# : 207 Perry City, State, ZIP Code : Rossville, Kansas 66533							Board of Agriculture, Division of Water Resources Application Number:			
3 LOCATE WELL'S LOCATION WITH AN "X" IN SECTION BOX: <div style="text-align: center;">  </div>			4 DEPTH OF COMPLETED WELL : 34 ft. ELEVATION: 953.38							
			Depth(s) Groundwater Encountered 1. ft. 2. ft. 3. ft. WELL'S STATIC WATER LEVEL ft. below land surface measured on: mo/day/yr Pump test data: Well water was NA ft. after hours pumping gpm Est. Yield NA gpm; Well water was ft. after hours pumping gpm Bore Hole Diameter . . . 8 in. to . . . 34 ft. and in. to ft. WELL WATER TO BE USED AS: 5 Public water supply 8 Air conditioning 11 Injection well 1 Domestic 3 Feedlot 6 Oil field water supply 9 Dewatering 12 Other (Specify below) 2 Irrigation 4 Industrial 7 Lawn and garden only 10 Monitoring well Was a chemical/bacteriological sample submitted to Department? Yes No <input checked="" type="checkbox"/> ; If yes, mo/day/yr sample was submitted Water Well Disinfected? Yes No <input checked="" type="checkbox"/>							
5 TYPE OF BLANK CASING USED:										
1 Steel		3 RMP (SR)		5 Wrought Iron		8 Concrete tile		CASING JOINTS: Glued Clamped		
2 PVC		4 ABS		6 Asbestos-Cement		9 Other (specify below)		Welded Threaded <input checked="" type="checkbox"/>		
Blank casing diameter . . . 2 in. to . . . 19 ft. Dia . . . in. to . . . ft.		Casing height above land surface . . . -5.4 in. weight . . . lbs./ft. Wall thickness or gauge No. Sch. 40								
TYPE OF SCREEN OR PERFORATION MATERIAL										
1 Steel			3 Stainless steel			5 Fiberglass			7 PVC	
2 Brass			4 Galvanized steel			6 Concrete tile			8 RMP (SR)	
SCREEN OR PERFORATION OPENINGS ARE:			5 Gauzed wrapped			8 Saw cut			11 None (open hole)	
1 Continuous slot			3 Mill slot			6 Wire wrapped			9 Drilled holes	
2 Louvered shutter			4 Key punched			7 Torch cut			10 Other (specify)	
SCREEN-PERFORATED INTERVALS: From . . . 19 ft. to . . . 34 ft.										
GRAVEL PACK INTERVALS: From . . . 17 ft. to . . . 34 ft.										
8 GROUT MATERIAL: 1 Neat cement 2 Cement grout 3 Bentonite 4 Other Concrete										
Grout Intervals: From . . . 0 ft. to . . . 1 ft. From . . . 1 ft. to . . . 17 ft. From . . . ft. to . . . ft.										
What is the nearest source of possible contamination:										
1 Septic tank			4 Lateral lines			7 Pit privy			10 Livestock pens	
2 Sewer lines			5 Cess pool			8 Sewage lagoon			11 Fuel storage	
3 Watertight sewer lines			6 Seepage pit			9 Feedyard			12 Fertilizer storage	
									13 Insecticide storage	
Direction from well?									14 Abandoned water well	
									15 Oil well/Gas well	
									16 Other (specify below)	
									How many feet?	
LITHOLOGIC LOG										
FROM		TO						PLUGGING INTERVALS		
0		1		Concrete and fill sand,						
1		6		Clay, sl. silty, Dark Gray						
6		12		Clay, sl. silty, Brown						
12		22		Silt, Lt. Brown						
22		26		Sand, vf-m, silty, Tan to Gray						
26		34		Sand, m to gravel, Tan						
MW9, Tag # 0043973, Flushmount										
7 CONTRACTOR'S OR LANDOWNER'S CERTIFICATION: This water well was (1) constructed, (2) reconstructed, or (3) plugged under my jurisdiction and was completed on (mo/day/year) 1/14/2011 and this record is true to the best of my knowledge and belief. Kansas Water Well Contractor's License No. 527 This Water Well Record was completed on (mo/day/yr) 1/26/2011 under the business name of GeoCore, Inc. by (signature) <i>Dale Hall</i>										
INSTRUCTIONS: Use typewriter or ball point pen; <u>PLEASE PRESS FIRMLY</u> and <u>PRINT</u> clearly. Please fill in blanks, underline or circle the correct answers. Send top three copies to Kansas Department of Health and Environment, Bureau of Water, Topeka, Kansas 66620-0001. Telephone: 913-286-5648. Send one to WATER WELL OWNER and retain one for your records.										

OFFICE USE ONLY
T
R
EAW
SEC.
%