

County: Wabaunsee Fraction W2 W2 NE SE Sec. 16 T 10 S R 12 EDW

CORRECTION(S) TO WATER WELL COMPLETION RECORD (WWC-5)

(to rectify lacking or incorrect information)

Owner: White Brothers Land & Livestock

Location was listed as:

Section-Township-Range: 7-10 S-12 E

Fraction ( $\frac{1}{4}$   $\frac{1}{4}$   $\frac{1}{4}$ ): SE SW NW NW

Location changed to:

16-10 S-12 E

W2 W2 NE SE

Other changes: Initial statements: Pottawatomie County

Latitude: 39.19874, Longitude: 96.12639

Changed to: Wabaunsee County

Latitude & longitude unknown.

Comments: Latitude & longitude given are for a well drilled by the same driller in a different section for a different owner.

Verification method: water rights information in WIMAS database, Wabaunsee County online parcel search, and mapping tool & aerial photos on KGS website.

initials: DRP date: 9/30/2015

Submitted by: Kansas Geological Survey, Data Resources Library, 1930 Constant Ave., Lawrence, KS 66047-3726  
to: Kansas Dept of Health & Environment, Bureau of Water, 1000 SW Jackson, Suite 420, Topeka, KS 66612-1367.

**WATER WELL RECORD**

**Form WWC-5**

Division of Water Resources App. No.


29,049

<b>1 LOCATION OF WATER WELL:</b> County: Pottawatomie	Fraction SE ¼ SW ¼ NW ¼ NW ¼	Section Number 7	Township No. T 10 S	Range Number R 12 <input checked="" type="checkbox"/> E <input type="checkbox"/> W
--	---------------------------------	---------------------	------------------------	---

Street/Rural Address of Well Location; if unknown, distance & direction from nearest town or intersection: If at owner's address, check here .  
From 1 mi. South of St. Mary's

**Global Positioning System (GPS) information:**  
Latitude: 39.19874..... (in decimal degrees)  
Longitude: 096.12639..... (in decimal degrees)  
Elevation: 929.....  
Datum:  WGS 84,  NAD 83,  NAD 27  
Collection Method:  
 GPS unit (Make/Model: Garmin Csx.....)  
 Digital Map/Photo,  Topographic Map,  Land Survey  
Est. Accuracy:  <3 m,  3-5 m,  5-15 m,  >15 m

**2 WATER WELL OWNER:** White Brothers Land & Livestock  
RR#, Street Address, Box #: 10705 Camp Creek Rd.  
City, State, ZIP Code : Belvue, Kansas 66407

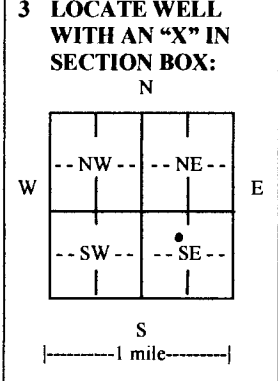

**4 DEPTH OF COMPLETED WELL 44**..... ft.  
Depth(s) Groundwater Encountered (1)..... ft. (2)..... ft. (3)..... ft.  
WELL'S STATIC WATER LEVEL 23..... ft. below land surface measured on mo/day/yr. 2-5-2013.....  
Pump test data: Well water was..... ft. after..... hours pumping..... gpm  
EST. YIELD.....gpm. Well water was..... ft. after..... hours pumping..... gpm  
Bore Hole Diameter.....in. to..... ft., and.....in. to..... ft.  
WELL WATER TO BE USED AS:  Public water supply  Geothermal  Injection well  
 Domestic  Feedlot  Oil field water supply  Dewatering  Other (Specify below)  
 Irrigation  Industrial  Domestic-lawn & garden  Monitoring well .....  
Was a chemical/bacteriological sample submitted to Department?  Yes  No  
If yes, mo/day/yr sample was submitted.....  
Water well disinfected?  Yes  No

**5 TYPE OF CASING USED:**  Steel  PVC  Other .....  
CASING JOINTS:  Glued  Clamped  Welded  Threaded Bolted  
Casing diameter .16..... in. to .34..... ft., Diameter..... in. to..... ft., Diameter..... in. to..... ft.  
Casing height above land surface. 24..... in., Weight SCH 40.....lbs./ft., Wall thickness or gauge No. 500.....  
TYPE OF SCREEN OR PERFORATION MATERIAL:  
 Steel  Stainless Steel  PVC  Other (Specify) .....  
 Brass  Galvanized Steel  None used (open hole)  
SCREEN OR PERFORATION OPENINGS ARE:  
 Continuous slot  Mill slot  Gauze wrapped  Torch cut  Drilled holes  None (open hole)  
 Louvered shutter  Key punched  Wire wrapped  Saw cut  Other (specify) .....  
SCREEN-PERFORATED INTERVALS: From .34..... ft. to .44..... ft., From..... ft. to..... ft.  
GRAVEL PACK INTERVALS: From .44..... ft. to .20..... ft., From..... ft. to..... ft.  
From..... ft. to..... ft., From..... ft. to..... ft.

**6 GROUT MATERIAL:**  Neat cement  Cement grout  Bentonite  Other .....  
Grout Intervals: From .20..... ft. to .0..... ft., From..... ft. to..... ft., From..... ft. to..... ft.  
What is the nearest source of possible contamination:  
 Septic tank  Lateral lines  Pit privy  Livestock pens  Insecticide storage  Other (specify below)  
 Sewer lines  Cesspool  Sewage lagoon  Fuel storage  Abandoned water well  
 Watertight sewer lines  Seepage pit  Feedyard  Fertilizer storage  Oil well/gas well None  
Direction from well ..... Distance from well .....

FROM	TO	LITHOLOGIC LOG	FROM	TO	LITHO. LOG (cont.) or PLUGGING INTERVALS
0	3	Top soil			
3	8	Brown clay			
8	25	Small sand with fine sand			
25	42	Small to medium sand with fine sand			
42	44	Medium sand, clay and shale mixed			

**7 CONTRACTOR'S OR LANDOWNER'S CERTIFICATION:** This water well was  constructed,  reconstructed, or  plugged under my jurisdiction and was completed on (mo/day/year) 2-5-2013..... and this record is true to the best of my knowledge and belief. Kansas Water Well Contractor's License No. 134..... This Water Well Record was completed on (mo/day/year)..... under the business name of Rosencrantz-Bemis Enterprise..... by (signature) Darrell A. Ooda.....

INSTRUCTIONS: Use typewriter or ball point pen. PLEASE PRESS FIRMLY and PRINT clearly. Please fill in blanks and check the correct answers. Send three copies (white, blue, pink) to Kansas Department of Health and Environment, Bureau of Water, Geology Section, 1000 SW Jackson St., Suite 420, Topeka, Kansas 66612-1367. Telephone 785-296-5524. Send one copy to WATER WELL OWNER and retain one for your records. Include fee of \$5.00 for each constructed well. Visit us at <http://www.kdheks.gov/waterwell/index.html>.