


WATER WELL RECORD      Form WWC-5      KSA 82a-1212

Distance and direction from nearest town or city street address of well if located within city?

2] WATER WELL OWNER: Pessimier Gb.

3 LOCATE WELL'S LOCATION WITH 4 DEPTH OF COMPLETED WELL 34 ft ELEVATION:

WELL'S STATIC WATER LEVEL .....<sup>17</sup> ft. below land surface measured on mo/day/yr 5-16-92 .....

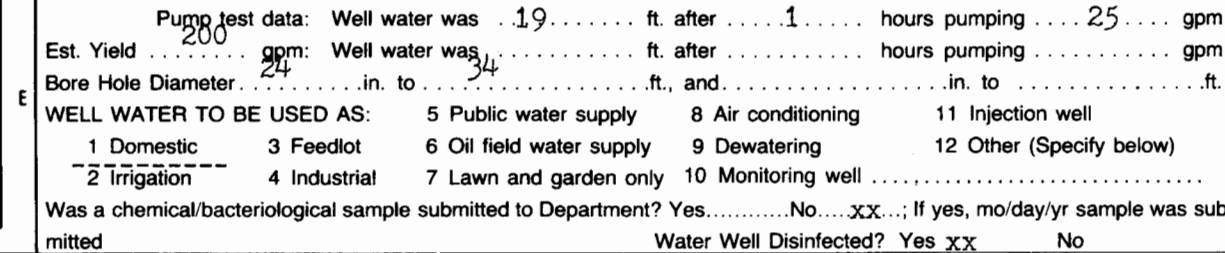

1 Steel                      3 RMP (SR)                      6 Asbestos-Cement                      9 Other (specify below)                      Welded . . . . .

Casing height above land surface.....12.....in., weight.....lbs./ft. Wall thickness or gauge No. ....375.....

1 Steel                      3 Stainless steel                      5 Fiberglass                      8 RMP (SR)                      11 Other (specify) .....

SCREEN OR PERFORATION OPENINGS ARE:

1. Continuous slot	3. Mill slot	5. Gauzed wrapped	7. Saw cut	9. None (open hole)
2. Wire-wrapped	4. Wire-wrapped	6. Wire-wrapped	8. Drilled holes	

SCREEN-PERFORATED INTERVALS: From 29 ft. to 34 ft. From \_\_\_\_\_ ft. to \_\_\_\_\_ ft.

GRAVEL PACK INTERVALS: From 17 ft. to 34 ft., From \_\_\_\_\_ ft. to \_\_\_\_\_ ft.

6) GROUT MATERIAL:		1 Neat cement		2 Cement grout		3 Bentonite		4 Other	
From	To	From	To	From	To	From	To	From	To
17	3								

1 Septic tank	4 Lateral lines	7 Pit privy	11 Fuel storage	15 Oil well/Gas well
---------------	-----------------	-------------	-----------------	----------------------

3 Watertight sewer lines    6 Seepage pit                      9 Feedyard                      13 Insecticide storage ..... creek .....

FROM	TO	LITHOLOGIC LOG	FROM	TO	FLUDDING INTERVALS
0	11	Fine brown silt			

7. CONTRACTOR'S OR LANDOWNER'S CERTIFICATION: This water well was (1) constructed, (2) reconstructed, or (3) plugged under my jurisdiction and was

Water Well Contractor's License No. 323 This Water Well Record was completed on (mo/day/yr) 5-17-92

INSTRUCTIONS: Use typewriter or ball point pen. PLEASE PRESS FIRMLY and PRINT clearly. Please fill in blanks, underline or circle the correct answers. Send top three copies to Kansas Department of Health and Environment, Bureau of Water, Topeka, Kansas 66602-0001. Telephone: 913-266-5545. Send one to WATER WELL OWNER and retain one for your records.

of Health and Environment, Bureau of Water, Topeka, Kansas 66620-0001. Telephone: 913-296-3545. Send one to WATER WELL OWNER and retain one for your records.