


1 LOCATION OF WATER WELL: County: Pottawatomie Fraction: NE 1/4 NE 1/4 SW 1/4 Section Number: 10 Township Number: T 10 S Range Number: R 12 EW

Distance and direction from nearest town or city street address of well if located within city?  
In St. Marys KS.

2 WATER WELL OWNER: Bernie's Self Suce  
 RR#, St. Address, Box #: 411 Betrand  
 City, State, ZIP Code: St Marys KS.  
 Board of Agriculture, Division of Water Resources  
 Application Number:

3 LOCATE WELL'S LOCATION WITH AN "X" IN SECTION BOX:

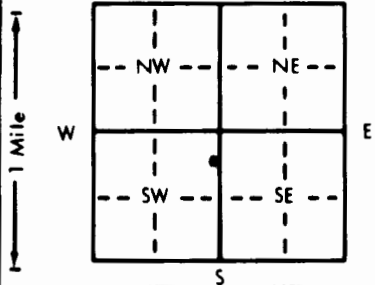

4 DEPTH OF COMPLETED WELL: 30 ft. ELEVATION:  
 Depth(s) Groundwater Encountered 1. 18 ft. 2. ft. 3. ft.  
 WELL'S STATIC WATER LEVEL 17.6 ft. below land surface measured on mo/day/yr 10-25-93  
 Pump test data: Well water was ft. after hours pumping gpm  
 Est. Yield gpm: Well water was ft. after hours pumping gpm  
 Bore Hole Diameter 7 1/2 in. to 30 ft. and in. to ft.  
 WELL WATER TO BE USED AS:  
 5 Public water supply 8 Air conditioning 11 Injection well  
 1 Domestic 3 Feedlot 6 Oil field water supply 9 Dewatering 12 Other (Specify below)  
 2 Irrigation 4 Industrial 7 Lawn and garden only  Monitoring well  
 Was a chemical/bacteriological sample submitted to Department? Yes No ; If yes, mo/day/yr sample was submitted  
 Water Well Disinfected? Yes

5 TYPE OF BLANK CASING USED:  
 1 Steel 3 RMP (SR) 5 Wrought iron 8 Concrete tile CASING JOINTS: Glued Clamped  
 PVC 4 ABS 6 Asbestos-Cement 9 Other (specify below) Welded  
 7 Fiberglass Threaded   
 Blank casing diameter 2.42 in. to 15 ft., Dia. in. to ft., Dia. in. to ft.  
 Casing height above land surface flush mt. 0 in., weight lbs./ft. Wall thickness or gauge No. Sch 40 sdr. 13

TYPE OF SCREEN OR PERFORATION MATERIAL:  
 1 Steel 3 Stainless steel 5 Fiberglass 8 RMP (SR) 10 Asbestos-cement  
 2 Brass 4 Galvanized steel 6 Concrete tile 9 ABS 11 Other (specify)  
 12 None used (open hole)

SCREEN OR PERFORATION OPENINGS ARE:  
 1 Continuous slot  Mill slot 5 Gauzed wrapped 8 Saw cut 11 None (open hole)  
 2 Louvered shutter 4 Key punched 6 Wire wrapped 9 Drilled holes  
 7 Torch cut 10 Other (specify)

SCREEN-PERFORATED INTERVALS: From 30 ft. to 15 ft., From ft. to ft.  
 From 7 ft. to ft., From ft. to ft.  
 GRAVEL PACK INTERVALS: From 30 ft. to 13 ft., From ft. to ft.  
 From ft. to ft., From ft. to ft.

6 GROUT MATERIAL: 1 Neat cement  Cement grout  Bentonite 4 Other  
 Grout Intervals: From 13 ft. to 4 ft., From 4 ft. to 0 ft., From ft. to ft.  
 What is the nearest source of possible contamination: (3) (2)  
 1 Septic tank 4 Lateral lines 7 Pit privy  Fuel storage 14 Abandoned water well  
 2 Sewer lines 5 Cess pool 8 Sewage lagoon 12 Fertilizer storage 15 Oil well/Gas well  
 3 Watertight sewer lines 6 Seepage pit 9 Feedyard 13 Insecticide storage 16 Other (specify below)  
 Direction from well? West How many feet? 40 Ft.

| FROM | TO   | LITHOLOGIC LOG                      | FROM | TO | PLUGGING INTERVALS |
|------|------|-------------------------------------|------|----|--------------------|
| 0    | 1.5  | concrete                            |      |    |                    |
| 1.5  | 5.5  | DK. brown to black silty clay       |      |    |                    |
| 5.5  | 11.5 | Med. brown to gray brown stiff clay |      |    |                    |
| 11.5 | 20   | Tan sandy silt                      |      |    |                    |
| 20   | 27.5 | Tan silty sand                      |      |    |                    |
| 27.5 | 30   | Med gray silty sand                 |      |    |                    |

7 CONTRACTOR'S OR LANDOWNER'S CERTIFICATION: This water well was  constructed, (2) reconstructed, or (3) plugged under my jurisdiction and was completed on (mo/day/year) 10-25-93 and this record is true to the best of my knowledge and belief. Kansas Water Well Contractor's License No. 539 This Water Well Record was completed on (mo/day/yr) 10-28-93 under the business name of JB Env. Drilling by (signature) James Bieber