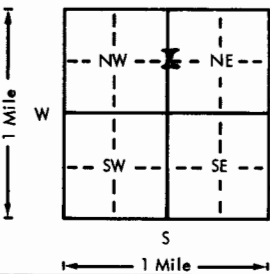
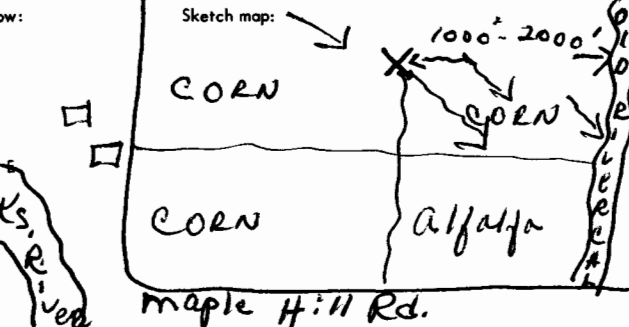


USE TYPEWRITER OR BALL
POINT PEN-PRESS FIRMLY,
PRINT CLEARLY.

WATER WELL RECORD
KSA 82a-1201-1215

Kansas Department of Health and
Environment-Division of Environment
(Water well Contractors)
Topeka, Kansas 66620

1. Location of well:	County Pottawatomie	Fraction Center of 1/4 Section	Section number 23	Township number T 10 S R 12 E/W	Range number
2. Distance and direction from nearest town or city: 1/8 mi. East & 2 mi. S. of St. Marys, Ks. on Maple Hill Rd.		3. Owner of well: Clarence Meyer R.R. or street: 301 Lasley St. City, state, zip code: St. Marys, Ks. 66536			
4. Locate with "X" in section below:		Sketch map:		6. Bore hole dia. 30 in. Completion date 10-15-76 Well depth 69 ft.	
				7. <input type="checkbox"/> Cable tool <input type="checkbox"/> Rotary <input type="checkbox"/> Driven <input type="checkbox"/> Dug <input type="checkbox"/> Hollow rod <input type="checkbox"/> Jetted <input checked="" type="checkbox"/> Bored <input type="checkbox"/> Reverse rotary	
5. Type and color of material		From	To	8. Use: <input type="checkbox"/> Domestic <input type="checkbox"/> Public supply <input type="checkbox"/> Industry <input checked="" type="checkbox"/> Irrigation <input type="checkbox"/> Air conditioning <input type="checkbox"/> Stock <input type="checkbox"/> Lawn <input type="checkbox"/> Oil field water <input type="checkbox"/> Other	
Fine sand & top soil		0	6	9. Casing: Material Trans Height: (Above or below Threaded <input type="checkbox"/> Welded <input type="checkbox"/> Surface 12" in. RMP <input type="checkbox"/> PVC <input type="checkbox"/> Weight <input type="checkbox"/> lbs./ft. Dia. 16 in. to 30 ft. depth Wall Thickness: inches or Dia. <input type="checkbox"/> in. to <input type="checkbox"/> ft. depth gage No. 7/8	
Fine sand		6	8	10. Screen: Manufacturer's name Johansson Type Transite Dia. 16" (Slo) gauge 1/8x8 Length 39' Set between 30 ft. and 69 ft. ft. and <input type="checkbox"/> ft. Gravel pack? yes Size range of material 5/8	
Gray sand stone		8	13	11. Static water level: <input type="checkbox"/> mo./day/yr. 16 ft. below land surface Date 10-15-76	
Fine sand		13	16	12. Pumping level below land surfaces: 18 ft. after 1 hrs. pumping 1000 g.p.m. 21 ft. after 3 hrs. pumping 1200 g.p.m. Estimated maximum yield 2000 g.p.m.	
Med. to Large green gravel		16	21	13. Water sample submitted: <input type="checkbox"/> Yes <input checked="" type="checkbox"/> No Date <input type="checkbox"/>	
Fine to Med. green gravel		21	26	14. Well head completion: <input type="checkbox"/> Pitless adapter <input type="checkbox"/> Inches above grade	
Fine to med. green gravel & some clay		26	29	15. Well grouted? yes With: <input type="checkbox"/> Neat cement <input type="checkbox"/> Bentonite <input checked="" type="checkbox"/> Concrete Depth: From 0 ft. to 10 ft.	
Med. to large green gravel & 1" to 3" stone.		29	30	16. Nearest source of possible contamination old river ft. 1800 Direction East Type channel Well disinfected upon completion? <input type="checkbox"/> Yes <input checked="" type="checkbox"/> No	
Med. to lg. green gravel & some clay		30	40	17. Pump: <input type="checkbox"/> Not installed Manufacturer's name <input type="checkbox"/> Model number <input type="checkbox"/> HP <input type="checkbox"/> Volts <input type="checkbox"/> Length of drop pipe <input type="checkbox"/> ft. capacity <input type="checkbox"/> g.p.m. Type: <input type="checkbox"/> Submersible <input type="checkbox"/> Turbine <input type="checkbox"/> Jet <input type="checkbox"/> Reciprocating <input type="checkbox"/> Centrifugal <input type="checkbox"/> Other	
Fine to med. green gravel		40	42	18. Water well contractor's certification: This well was drilled under my jurisdiction and this report is true to the best of my knowledge and belief. Hoobler Drilling Co. 323 Business name License No. Address St. Marys, Ks. 66536 Signed Don Hoobler Date 10-27-76	
Med. to large green gravel		42	69		
Large red rocks-stopped.		69			
(Use a second sheet if needed)					
18. Elevation:	19. Remarks: We do not install pumps.				
Topography: <input type="checkbox"/> Hill <input type="checkbox"/> Slope <input type="checkbox"/> Upland <input checked="" type="checkbox"/> Valley					

Forward the white, blue and pink copies to the Department of Health and Environment

Form WWC-5