


1 LOCATION OF WATER WELL: Fractic Section Number 28 Township Number T 10 S Range Number R 12 EW
 County: Pott. Near center north side NE 1/4

Distance and direction from nearest town or city street address of well if located within city? 2.5 mi. south of St. Marys Ks.

2 WATER WELL OWNER: Bert Falley Board of Agriculture, Division of Water Resources
 RR#, St. Address, Box #: 1632 N.W. Grove Ave Application Number: 24,020
 City, State, ZIP Code: Topeka Ks. 66606

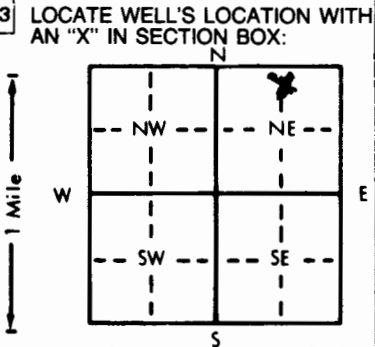

4 DEPTH OF COMPLETED WELL... 66 ft. ELEVATION: ...
 Depth(s) Groundwater Encountered 1... 22 ft. 2... ft. 3... ft.
 WELL'S STATIC WATER LEVEL ... 22 ft. below land surface measured on mo/day/yr 1-22-92
 Pump test data: Well water was 37 ft. after 1 hours pumping 800 gpm
 Est. Yield 1200 gpm: Well water was 49 ft. after 1 hours pumping 1200 gpm
 Bore Hole Diameter: 32 in. to 66 ft., and... in. to... ft.
 WELL WATER TO BE USED AS: 5 Public water supply 8 Air conditioning 11 Injection well
 1 Domestic 3 Feedlot 6 Oil field water supply 9 Dewatering 12 Other (Specify below)
 2 Irrigation 4 Industrial 7 Lawn and garden only 10 Monitoring well
 Was a chemical/bacteriological sample submitted to Department? Yes... No... XX; If yes, mo/day/yr sample was submitted
 Water Well Disinfected? Yes No XX

5 TYPE OF BLANK CASING USED: 5 Wrought iron 8 Concrete tile CASING JOINTS: Glued XX Clamped
 1 Steel 3 RMP (SR) 6 Asbestos-Cement 9 Other (specify below) Welded
 2 PVC 4 ABS 7 Fiberglass Threaded
 Blank casing diameter 16 in. to 46 ft., Dia... in. to... ft., Dia... in. to... ft.
 Casing height above land surface 12 in., weight... lbs./ft. Wall thickness or gauge No. 50
 TYPE OF SCREEN OR PERFORATION MATERIAL: 7 PVC 10 Asbestos-cement
 1 Steel 3 Stainless steel 5 Fiberglass 8 RMP (SR) 11 Other (specify)
 2 Brass 4 Galvanized steel 6 Concrete tile 9 ABS 12 None used (open hole)
 SCREEN OR PERFORATION OPENINGS ARE: 5 Gauzed wrapped 8 Saw cut 11 None (open hole)
 1 Continuous slot 3 Mill slot 6 Wire wrapped 9 Drilled holes
 2 Louvered shutter 4 Key punched 7 Torch cut 10 Other (specify)
 SCREEN-PERFORATED INTERVALS: From 46 ft. to 66 ft., From... ft. to... ft.
 GRAVEL PACK INTERVALS: From 20 ft. to 66 ft., From... ft. to... ft.

6 GROUT MATERIAL: 1 Neat cement 2 Cement grout 3 Bentonite 4 Other
 Grout intervals: From 0 ft. to 20 ft., From... ft. to... ft., From... ft. to... ft.
 What is the nearest source of possible contamination:
 1 Septic tank 4 Lateral lines 7 Pit privy 10 Livestock pens 14 Abandoned water well
 2 Sewer lines 5 Cess pool 8 Sewage lagoon 11 Fuel storage 15 Oil well/Gas well
 3 Watertight sewer lines 6 Seepage pit 9 Feedyard 12 Fertilizer storage 16 Other (specify below)
 13 Insecticide storage
 Direction from well? north How many feet? 65 ft.

FROM	TO	LITHOLOGIC LOG	FROM	TO	PLUGGING INTERVALS
0	4	Brown silt			
4	25	Fine brown sand			
25	30	Medium brown gravel			
30	37	Medium green gravel			
37	65	Medium-large green gravel			
65	66	Weathered shale, stopped			

7 CONTRACTOR'S OR LANDOWNER'S CERTIFICATION: This water well was (1) constructed, (2) reconstructed, or (3) plugged under my jurisdiction and was completed on (mo/day/year) 1-21-92 and this record is true to the best of my knowledge and belief. Kansas Water Well Contractor's License No. 323 This Water Well Record was completed on (mo/day/yr) 2-6-92 under the business name of Hoobler Drilling Co. by (signature)

INSTRUCTIONS: Use typewriter or ball point pen. PLEASE PRESS FIRMLY and PRINT clearly. Please fill in blanks, underline or circle the correct answers. Send top three copies to Kansas Department of Health and Environment, Bureau of Water, Topeka, Kansas 66620-0001. Telephone: 913-296-5545. Send one to WATER WELL OWNER and retain one for your records.

OFFICE USE ONLY
T
R
EW
SEC.
1/4
1/4
1/4