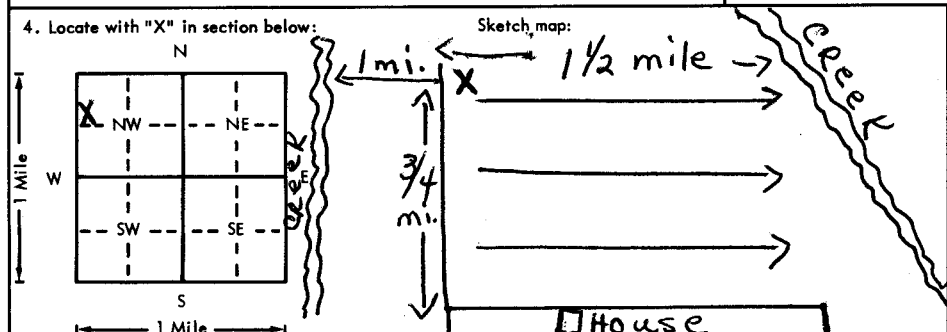


USE TYPEWRITER OR BALL-  
POINT PEN-PRESS FIRMLY  
PRINT CLEARLY

WATER WELL RECORD  
KSA 82a-1201-1215

Kansas Department of Health and  
Environment-Division of Environment  
(Water well Contractors)  
Topeka, Kansas 66620

1. Location of well: County <b>SHAWNEE</b>		Fraction <b>SW 1/4 NW 1/4 NW 1/4</b>		Section number <b>24</b>	Township number <b>10</b>	Range number <b>12</b>	<b>EW</b>
2. Distance and direction from nearest town or city: <b>2 miles East</b> Street address of well location if in city: <b>1 1/2 South of St. Marys, Ks.</b>				3. Owner of well: <b>Phil DeDonder</b> R.R. or street: <b>R.R. #1</b> City, state, zip code: <b>St. Marys, Ks. 66536</b>			
4. Locate with "X" in section below: 				6. Bore hole dia. <b>32</b> in. Completion date <b>12-15-75</b> Well depth <b>55</b> ft.			
5. Type and color of material				From	To	7. <input type="checkbox"/> Cable tool <input type="checkbox"/> Rotary <input type="checkbox"/> Driven <input type="checkbox"/> Dug <input type="checkbox"/> Hollow rod <input type="checkbox"/> Jetted <input type="checkbox"/> Bored <input checked="" type="checkbox"/> Reverse rotary	
1'---14' topsoil				1'	14'	8. Use: <input type="checkbox"/> Domestic <input type="checkbox"/> Public supply <input type="checkbox"/> Industry <input checked="" type="checkbox"/> Irrigation <input type="checkbox"/> Air conditioning <input type="checkbox"/> Stock <input type="checkbox"/> Lawn <input type="checkbox"/> Oil field water <input type="checkbox"/> Other	
Fine Sand & small gravel				14'	20'	9. Casing: Material <b>concrete</b> Joint: <b>above</b> or below Threaded <input type="checkbox"/> Welded <input type="checkbox"/> Surface <b>12</b> in. RMP <input type="checkbox"/> PVC <input type="checkbox"/> Weight <b>120</b> lbs./ft. Dia. <b>16</b> in. to <b>55</b> ft. depth Wall Thickness <b>2</b> inches or Dia. <input type="checkbox"/> in. to <input type="checkbox"/> ft. depth gage No. <input type="checkbox"/>	
Small green gravel				20'	24'	10. Screen: Manufacturer's name <b>Kelly Well Co.</b> Type <b>concrete</b> Dia. <b>16</b> Slot/gauze <b>slot</b> Length <b>28</b> Set between <b>37</b> ft. and <b>55</b> ft. ft. and <b>5/8</b> ft. Gravel pack? <input checked="" type="checkbox"/> Size range of material <input type="checkbox"/>	
Large green gravel				24'	28'	11. Static water level: <input type="checkbox"/> mo./day/yr. <b>22</b> ft. below land surface Date <b>12-17-75</b>	
Medium green gravel				28'	30'	12. Pumping level below land surfaces: <b>37</b> ft. after <b>2</b> hrs. pumping <b>1000</b> g.p.m. <b>33</b> ft. after <b>2</b> hrs. pumping <b>1200</b> g.p.m. Estimated maximum yield <b>2000</b> g.p.m.	
Large green gravel & large rocks				30'	55'	13. Water sample submitted: <input type="checkbox"/> mo./day/yr. Yes <input type="checkbox"/> No <input checked="" type="checkbox"/> Date <input type="checkbox"/>	
Yellow Clay stopped				55'		14. Well head completion: <input type="checkbox"/> Pitless adapter <input type="checkbox"/> inches above grade	
						15. Well grouted? <b>yes</b> With: <input type="checkbox"/> Neat cement <input type="checkbox"/> Bentonite <input checked="" type="checkbox"/> Concrete Depth: From <b>0</b> ft. to <b>10</b> ft.	
						16. Nearest source of possible contamination: ft. <b>5000</b> Direction <b>WEST</b> Type <b>CREEK</b> Well disinfected upon completion? <input type="checkbox"/> Yes <input checked="" type="checkbox"/> No	
						17. Pump: <input checked="" type="checkbox"/> Not installed Manufacturer's name <input type="checkbox"/> Model number <input type="checkbox"/> HP <input type="checkbox"/> Volts <input type="checkbox"/> Length of drop pipe <input type="checkbox"/> ft. capacity <input type="checkbox"/> g.p.m. Type: <input type="checkbox"/> Submersible <input type="checkbox"/> Turbine <input type="checkbox"/> Jet <input type="checkbox"/> Reciprocating <input type="checkbox"/> Centrifugal <input type="checkbox"/> Other	
						20. Water well contractor's certification: This well was drilled under my jurisdiction and this report is true to the best of my knowledge and belief. <b>HOOBLER DRILLING CO. 323</b> Business name <input type="checkbox"/> License No. <input type="checkbox"/> Address <b>ST. MARYS, KS. 66536</b> Signed <b>Don Halibur</b> Date <b>12-20</b> Authorized representative	
18. Elevation: <b>937'</b> Topography: <input type="checkbox"/> Hill <input type="checkbox"/> Slope <input checked="" type="checkbox"/> Upland <input type="checkbox"/> Valley		19. Remarks:					

Forward the white, blue and pink copies to the Department of Health and Environment

Form WWC-5