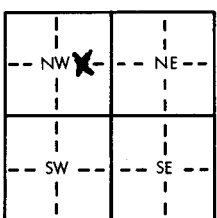
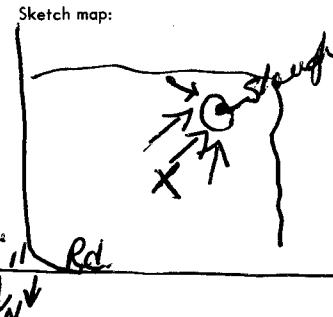


Kansas Department of Health and
Environment-Division of Environment
(Water well Contractors)
Topeka, Kansas 66620

NW SE NW

1. Location of well: Shawnee		Fraction B D B	Section number 25	Township number 10S	Range number 12E
2. Distance and direction from nearest town or city: 2 mi. So. 2 mi. E. & 4 mi. south on Maple Hill Rd. from St. Marys, Ks.		3. Owner of well: Jerry Pearl R.R. or street: St. Marys, Ks. 66536 City, state, zip code:			
4. Locate with "X" in section below: 		Sketch map: 		6. Bore hole dia. 30 in. Completion date 12-27-76 Well depth 79 ft.	
5. Type and color of material		From	To	7. <input type="checkbox"/> Cable tool <input type="checkbox"/> Rotary <input type="checkbox"/> Driven <input type="checkbox"/> Aug <input type="checkbox"/> Hollow rod <input type="checkbox"/> Jetted <input type="checkbox"/> Bored <input checked="" type="checkbox"/> Reverse rotary	
Fine brown top soil & sand		0	7	8. Use: <input type="checkbox"/> Domestic <input type="checkbox"/> Public supply <input type="checkbox"/> Industry <input checked="" type="checkbox"/> Irrigation <input type="checkbox"/> Air conditioning <input type="checkbox"/> Stock <input type="checkbox"/> Lawn <input type="checkbox"/> Oil field water <input type="checkbox"/> Other	
Brown silt		7	16	9. Casing: Material Trans Height (Above or below Threaded <input type="checkbox"/> Welded <input type="checkbox"/> Surface 12 in. RMP <input type="checkbox"/> PVC <input type="checkbox"/> Weight <input type="checkbox"/> lbs./ft. Dia. 16 in. to 40 ft. depth Wall Thickness: inches or Dia. <input type="checkbox"/> in. to <input type="checkbox"/> ft. depth gage No. 7/8	
Med. green gravel		16	28	10. Screen: Manufacturer's name Johnson Well Type Transite Dia. 16" Slot/gauze 1/8x8 Length 39' Set between 40 ft. and 79 ft. Gravel pack? yes Size range of material 5/8	
Large green gravel		28	79	11. Static water level: <input type="checkbox"/> mo./day/yr. 22 ft. below land surface Date 12-27-76	
Large rock-stopped.		79		12. Pumping level below land surfaces: 31 ft. after 1 hrs. pumping 1000 g.p.m. 35 ft. after 3 hrs. pumping 1200 g.p.m. Estimated maximum yield 2000 g.p.m.	
				13. Water sample submitted: <input type="checkbox"/> Yes <input checked="" type="checkbox"/> No Date	
				14. Well head completion: <input type="checkbox"/> Pitless adapter <input type="checkbox"/> Inches above grade	
				15. Well grouted? yes With: <input type="checkbox"/> Neat cement <input type="checkbox"/> Bentonite <input checked="" type="checkbox"/> Concrete Depth: From 0 ft. to 10 ft.	
				16. Nearest source of possible contamination: ft. 200 Direction south Type slough Well disinfected upon completion? <input type="checkbox"/> Yes <input checked="" type="checkbox"/> No	
				17. Pump: <input checked="" type="checkbox"/> Not installed Manufacturer's name Model number HP Volts Length of drop pipe ft. capacity g.p.m. Type: <input type="checkbox"/> Submersible <input type="checkbox"/> Turbine <input type="checkbox"/> Jet <input type="checkbox"/> Reciprocating <input type="checkbox"/> Centrifugal <input type="checkbox"/> Other	
18. Elevation: 934 Topography: <input type="checkbox"/> Hill <input type="checkbox"/> Slope <input type="checkbox"/> Upland <input checked="" type="checkbox"/> Valley		19. Remarks: We do not install pumps.		20. Water well contractor's certification: This well was drilled under my jurisdiction and this report is true to the best of my knowledge and belief. Hoobler Drilling Co. 323 Business name License No. Address St. Marys, Ks. 66536 Signed Don Hoobler Date 12-27-76 Authorized representative	

Forward the white, blue and pink copies to the Department of Health and Environment

Form WWC-5