

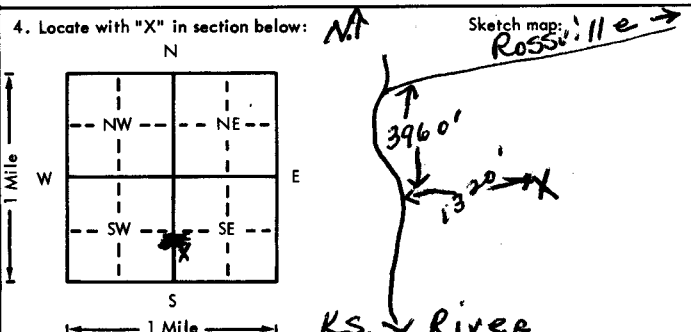
219

chg loc
jd

USE TYPEWRITER OR BALL
POINT PEN-PRESS FIRMLY,
PRINT CLEARLY.

WATER WELL RECORD
KSA 82a-1201-1215

Kansas Department of Health and
Environment-Division of Environment
(Water well Contractors)
Topeka, Kansas 66620

1. Location of well:		County Shawnee	Fraction NW SW 1/4 SE 1/4	Section number 36	Township number T 10 ()	Range number R 12 (E/W)
2. Distance and direction from nearest town or city: 1 mi. E. of Hi. 24, 2 mi. S., 2 mi. E., 2 1/2 S. of St. Marys, Ks. Street address of well location if in city:			3. Owner of well: Laird French R.R. or street: City, state, zip code: Rossville, Ks. 66533			
4. Locate with "X" in section below: 			6. Bore hole dia. 30 in. Completion date 7-15-76 Well depth 41 ft.			
5. Type and color of material			7. <input type="checkbox"/> Cable tool <input type="checkbox"/> Rotary <input type="checkbox"/> Driven <input type="checkbox"/> Dug <input type="checkbox"/> Hollow rod <input type="checkbox"/> Jetted <input checked="" type="checkbox"/> Bored <input type="checkbox"/> Reverse rotary			
			8. Use: <input checked="" type="checkbox"/> Domestic <input type="checkbox"/> Public supply <input type="checkbox"/> Industry <input checked="" type="checkbox"/> Irrigation <input type="checkbox"/> Air conditioning <input type="checkbox"/> Stock <input type="checkbox"/> Lawn <input type="checkbox"/> Oil field water <input type="checkbox"/> Other			
			9. Casing: Material Transite Height Above or below Threaded <input type="checkbox"/> Welded <input type="checkbox"/> Surface 12 in. RMP <input type="checkbox"/> PVC <input type="checkbox"/> Weight <input type="checkbox"/> lbs./ft. Dia. 16 in. to 15 ft. depth Wall Thickness, inches or Dia. <input type="checkbox"/> in. to <input type="checkbox"/> ft. depth gage No. 7/8			
			10. Screen: Manufacturer's name Johnson Well Co. Type Transite Dia. 16" Slot/gauze 1/8x8 Length 26' Set between 15 ft. and 41 ft. ft. and <input type="checkbox"/> ft. Gravel pack? yes Size range of material 5/8			
			11. Static water level: 14 ft. below land surface Date 7-15-76 mp./day/yr.			
			12. Pumping level below land surfaces: 17 ft. after 1 hrs. pumping 1000 g.p.m. 21 ft. after 2 hrs. pumping 1000 g.p.m. Estimated maximum yield 1500 g.p.m.			
			13. Water sample submitted: <input checked="" type="checkbox"/> Yes <input type="checkbox"/> No Date <input type="checkbox"/>			
			14. Well head completion: <input type="checkbox"/> Pitless adapter <input type="checkbox"/> Inches above grade			
			15. Well grouted? yes With: <input type="checkbox"/> Neat cement <input type="checkbox"/> Bentonite <input checked="" type="checkbox"/> Concrete Depth: From 0 ft. to 11 ft.			
			16. Nearest source of possible contamination: ft. 1300' Direction East Type creek Well disinfected upon completion? <input type="checkbox"/> Yes <input checked="" type="checkbox"/> No			
			17. Pump: <input checked="" type="checkbox"/> Not installed Manufacturer's name <input type="checkbox"/> Model number <input type="checkbox"/> HP <input type="checkbox"/> Volts <input type="checkbox"/> Length of drop pipe <input type="checkbox"/> ft. capacity <input type="checkbox"/> g.p.m. Type: <input type="checkbox"/> Submersible <input type="checkbox"/> Turbine <input type="checkbox"/> Jet <input type="checkbox"/> Reciprocating <input type="checkbox"/> Centrifugal <input type="checkbox"/> Other			
18. Elevation: 926 Rm Topography: <input type="checkbox"/> Hill <input type="checkbox"/> Slope <input checked="" type="checkbox"/> Upland <input type="checkbox"/> Valley			19. Remarks: We do not install pumps.			
			20. Water well contractor's certification: This well was drilled under my jurisdiction and this report is true to the best of my knowledge and belief. Hoobler Drilling Co. 323 Business name St. Marys, Ks. 66536 License No. <input type="checkbox"/> Address St. Marys, Ks. 66536 Signed Don Hoobler Date 7-15-76 Authorized representative			

Forward the white, blue and pink copies to the Department of Health and Environment

Form WWC-3