

58

112

USE TYPEWRITER OR BALL POINT PEN-PRESS FIRMLY, PRINT CLEARLY.

St Marys


WATER WELL RECORD
KSA 82a-1201-1215

Kansas Department of Health and Environment-Division of Environment
(Water well Contractors)
Topeka, Kansas 66620

ABA

1. Location of well: County WABAVNSEE Fraction NW NE NE 1/4 NE 1/4 NW 1/4 Section number 17 Township number T 10 S R 12 EW Range number EW

2. Distance and direction from nearest town or city: 2 SW 3/4 W 3. Owner of well: RUTH URBAN SKEY
Street address of well location if in city: of St Marys R.R. or street:
City, state, zip code: ST MARYS KS 66536

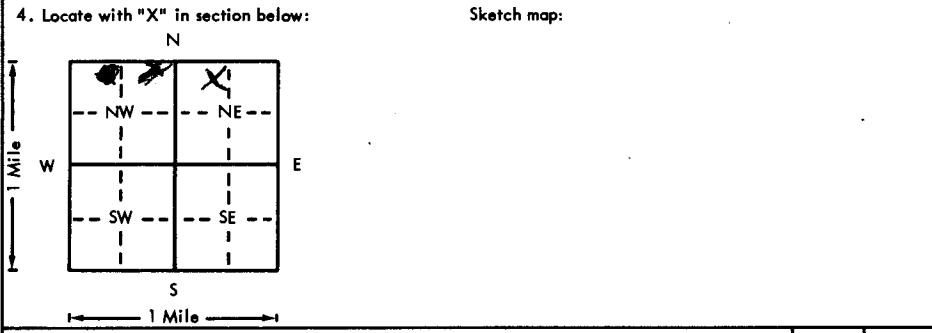

6. Bore hole dia. 30 in. Completion date 1975
Well depth 46 ft. 3-19-75
7. Cable tool Rotary Driven Dug
 Hollow rod Jetted Bored Reverse rotary
8. Use: Domestic Public supply Industry
 Irrigation Air conditioning Stock
 Lawn Oil field water Other
9. Casing: Material AC Height: Above or below
Threaded Welded Surface 12 in.
RMP PVC Weight 34 lbs./ft.
Dia. 16 in. to 46 ft. depth Wall Thickness: inches or
Dia. in. to ft. depth gage No. 34

5. Type and color of material	From	To
<u>TOP SOIL + CLAY</u>	<u>0</u>	<u>16</u>
<u>SAND</u>	<u>16</u>	<u>22</u>
<u>GRAVEL - FAIR</u>	<u>22</u>	<u>26</u>
<u>GOOD GRAVEL</u>	<u>26</u>	<u>32</u>
<u>REAL GOOD GRAVEL</u>	<u>32</u>	<u>46</u>
<u>SHALE</u>	<u>46</u>	
(Use a second sheet if needed)		

10. Screen: Manufacturer's name JOHANSON CONCRETE CO.
Type TRANSITE Dia. 16
Slot/gauge 1/8 Length 26
Set between 20 ft. and 46 ft.
Gravel pack? YES Size range of material 10-14
11. Static water level: 15 ft. below land surface Date 3-19-75 mo./day/yr.
12. Pumping level below land surfaces:
43 ft. after 1/2 hrs. pumping 1000 g.p.m.
ft. after hrs. pumping g.p.m.
Estimated maximum yield 1200 g.p.m.
13. Water sample submitted: mo./day/yr.
Yes No Date
14. Well head completion:
 Pitless adapter 12 Inches above grade
15. Well grouted? NOTE
With: Neat cement Bentonite Concrete
Depth: From ft. to ft.
16. Nearest source of possible contamination: NONE
ft. Direction Type
Well disinfected upon completion? Yes No
17. Pump: Not installed
Manufacturer's name
Model number HP Volts
Length of drop pipe ft. capacity g.p.m.
Type:
 Submersible Turbine
 Jet Reciprocating
 Centrifugal Other

18. Elevation: 946
Topography:
 Hill
 Slope
 Upland
 Valley

19. Remarks:
BOB BRUNINI - RENTER
FARMERS UNION IMP. ST. MARYS
SET THE PUMP & GROUTED WELL

18. Water well contractor's certification:
This well was drilled under my jurisdiction and this report is true to the best of my knowledge and belief.
GEO COX + SONS, INC 258
Business name CLIFTON KANSAS License No.
Address
Signed Francis Cox Date 11-29-75
Authorized representative

T 10 S R 12 EW