

CORRECTION(S) TO WATER WELL RECORD (WWC-5)

(to rectify lacking or incorrect information)

Location listed as:

Section-Township-Range: _____

Fraction ($\frac{1}{4}$ $\frac{1}{4}$ $\frac{1}{4}$): _____

County: Pottawatomie

Location changed to:

28-10S-12E

SE SE NE

Other changes: Initial statements: Wabunsee County

Changed to: Pottawatomie County

Comments: _____

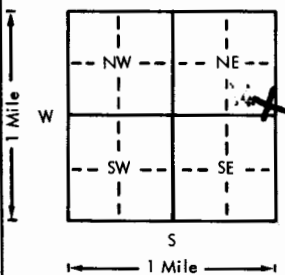
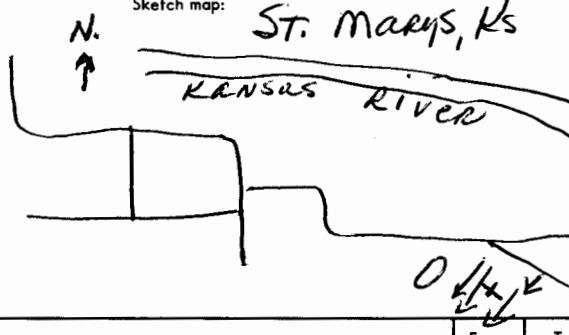
verification method: Written & legal descriptions, sketch map, position
on plat map, and St. Marys 1:24,000 topo. map.

initials: DR date: 11/1/2005

55
USE TYPEWRITER OR BALL
POINT PEN-PRESS FIRMLY,
PRINT CLEARLY.

WATER WELL RECORD
KSA 82a-1201-1215

Kansas Department of Health and
Environment-Division of Environment
(Water well Contractors)
Topeka, Kansas 66620

1. Location of well:	County Wabunsee	Fraction SE 1/4 SE 1/4 NE 1/4	Section number 28	Township number T 10 S	Range number R 12 (EW)
2. Distance and direction from nearest town or city: 4 1/2 Miles South of St. Marys, Ks. Street address of well location if in city:			3. Owner of well: J. B. Farms R.R. or street: 1200 Merchants Nat'l. Bank Bldg. City, state, zip code: Topeka, Kansas		
4. Locate with "X" in section below: 			Sketch map: ST. Marys, Ks 		
5. Type and color of material			From	To	6. Bore hole dia. 30 in. Completion date 4-21-76 Well depth 47 ft.
Sandy loam			0	1	7. <input type="checkbox"/> Cable tool <input type="checkbox"/> Rotary <input type="checkbox"/> Driven <input type="checkbox"/> Dug <input type="checkbox"/> Hollow rod <input type="checkbox"/> Jetted <input type="checkbox"/> Bored <input checked="" type="checkbox"/> Reverse rotary
Fine Sand			1	8	8. Use: <input type="checkbox"/> Domestic <input type="checkbox"/> Public supply <input type="checkbox"/> Industry <input checked="" type="checkbox"/> Irrigation <input type="checkbox"/> Air conditioning <input type="checkbox"/> Stock <input type="checkbox"/> Lawn <input type="checkbox"/> Oil field water <input type="checkbox"/> Other
Small brown sand			8	22	9. Casing: Material Trans Height: (Above) or below Threaded <input type="checkbox"/> Welded <input type="checkbox"/> Surface 12 in. RMP <input type="checkbox"/> PVC <input type="checkbox"/> Weight <input type="checkbox"/> lbs./ft. Dia. 16 in. to 21 ft. depth <input checked="" type="checkbox"/> Well Thickness: inches or Dia. <input type="checkbox"/> in. to <input type="checkbox"/> ft. depth <input checked="" type="checkbox"/> Gauge No. 75
Small brown gravel			22	25	10. Screen: Manufacturer's name Johnson Well Transite Dia. 16" Type Transite Length 26' (Slo) gauze 1/8" Set between 47 ft. and 21 ft. ft. and <input type="checkbox"/> ft. and <input type="checkbox"/> ft. Gravel pack? yes Size range of material 5/8
Large brown gravel			25	27	11. Static water level: <input type="checkbox"/> mo./day/yr. 19 ft. below land surface Date 4-21-76
Large green gravel			27	47	12. Pumping level below land surfaces: 21 ft. after 1 hrs. pumping 1000 g.p.m. 25 ft. after 3 hrs. pumping 1000 g.p.m. Estimated maximum yield 2000 g.p.m.
Hard gray clay-stopped.			47		13. Water sample submitted: <input type="checkbox"/> Yes <input checked="" type="checkbox"/> No Date <input type="checkbox"/> mo./day/yr.
					14. Well head completion: <input type="checkbox"/> Pitless adapter <input type="checkbox"/> inches above grade
					15. Well grouted? yes With: <input type="checkbox"/> Neat cement <input type="checkbox"/> Bentonite <input checked="" type="checkbox"/> Concrete Depth: From 0 ft. to 10 ft.
					16. Nearest source of possible contamination: ft. 1000 Direction NW Type Old Pond Well disinfected upon completion? <input type="checkbox"/> Yes <input checked="" type="checkbox"/> No
					17. Pump: <input checked="" type="checkbox"/> Not installed Manufacturer's name <input type="checkbox"/> Model number <input type="checkbox"/> HP <input type="checkbox"/> Volts <input type="checkbox"/> Length of drop pipe <input type="checkbox"/> ft. capacity <input type="checkbox"/> g.p.m. Type: <input type="checkbox"/> Submersible <input type="checkbox"/> Turbine <input type="checkbox"/> Jet <input type="checkbox"/> Reciprocating <input type="checkbox"/> Centrifugal <input type="checkbox"/> Other
(Use a second sheet if needed)					
18. Elevation: 936' Topography: <input type="checkbox"/> Hill <input type="checkbox"/> Slope <input type="checkbox"/> Upland <input checked="" type="checkbox"/> Valley	19. Remarks: 936'				
20. Water well contractor's certification: This well was drilled under my jurisdiction and this report is true to the best of my knowledge and belief. Hoobler Drilling Co. 323 Business name License No. Address St. Marys, Ks. 66536 Signed Don Hoobler Date 4-21-76 Authorized representative					