


1 LOCATION OF WATER WELL: County: SHAWNEE Fraction NW 1/4 SW 1/4 NW 1/4 Section Number 14 Township Number T 10 S Range Number R 13

Distance and direction from nearest town or city street address of well if located within city?  
WELL LOCATED AT 135 COPE STREET WILLARD KS.

2 WATER WELL OWNER: CITY OF WILLARD RR#, St. Address, Box # : WILLARD KS 66615-9509 Board of Agriculture, Division of Water Resources Application Number:

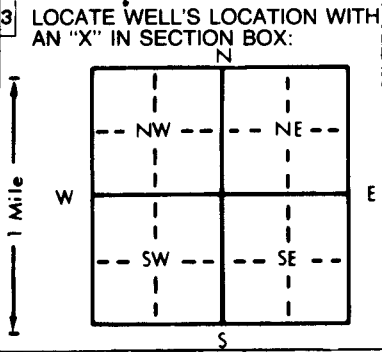

4 DEPTH OF COMPLETED WELL: 67 ft. ELEVATION: ABANDONED  
Depth(s) Groundwater Encountered 1. 18 ft. 2. ft. 3. ft.  
WELL'S STATIC WATER LEVEL . 18 ft. below land surface measured on mo/day/yr . 4-19-96  
Pump test data: Well water was . ft. after . hours pumping . gpm  
Est. Yield . gpm: Well water was . ft. after . hours pumping . gpm  
Bore Hole Diameter . in. to . ft., and . in. to . ft.  
WELL WATER TO BE USED AS: 5 Public water supply 8 Air conditioning 11 Injection well  
1 Domestic 3 Feedlot 6 Oil field water supply 9 Dewatering 12 Other (Specify below)  
2 Irrigation 4 Industrial 7 Lawn and garden only 10 Monitoring well  
Was a chemical/bacteriological sample submitted to Department? Yes. No. XX; If yes, mo/day/yr sample was submitted  
Water Well Disinfected? Yes XX No

5 TYPE OF BLANK CASING USED: 1 Steel 3 RMP (SR) 5 Wrought iron 8 Concrete tile CASING JOINTS: Glued . XX . Clamped .  
2 PVC 4 ABS 6 Asbestos-Cement 9 Other (specify below) Welded .  
7 Fiberglass Threaded .

Blank casing diameter . 5 in. to . ft., Dia . in. to . ft., Dia . in. to . ft.  
Casing height above land surface . 7' BELOW . in., weight . lbs./ft. Wall thickness or gauge No. .

TYPE OF SCREEN OR PERFORATION MATERIAL: 1 Steel 3 Stainless steel 5 Fiberglass 8 RMP (SR) 10 Asbestos-cement 11 Other (specify) . UNKNOWN .  
2 Brass 4 Galvanized steel 6 Concrete tile 9 ABS 12 None used (open hole)

SCREEN OR PERFORATION OPENINGS ARE: NA. 5 Gauzed wrapped 8 Saw cut 11 None (open hole)  
1 Continuous slot 3 Mill slot 6 Wire wrapped 9 Drilled holes  
2 Louvered shutter 4 Key punched 7 Torch cut 10 Other (specify) .

SCREEN-PERFORATED INTERVALS: From . NA. 999 ft. to . 999 ft., From . ft. to . ft.  
From . ft. to . ft., From . ft. to . ft.  
GRAVEL PACK INTERVALS: From . NA. ft. to . ft., From . ft. to . ft.  
From . ft. to . ft., From . ft. to . ft.

6 GROUT MATERIAL: 1 Neat cement 2 Cement grout 3 Bentonite 4 Other .  
Grout Intervals: From . 18 ft. to . 7 ft., From . ft. to . ft., From . ft. to . ft.

What is the nearest source of possible contamination:  
1 Septic tank 4 Lateral lines 7 Pit privy 10 Livestock pens 14 Abandoned water well  
2 Sewer lines 5 Cess pool 8 Sewage lagoon 11 Fuel storage 15 Oil well/Gas well  
3 Watertight sewer lines 6 Seepage pit 9 Feedyard 12 Fertilizer storage 16 Other (specify below)  
13 Insecticide storage . NONE .

Direction from well? How many feet?

FROM	TO	LITHOLOGIC LOG	FROM	TO	PLUGGING INTERVALS
			67	18	WASHED UD 1- CHLORINATED
			18	7	3/8 GRANULAR BENTONITE
			7	0	CASING REMOVED AND COVERED OVER WITH COMPACTED SURFACE SOILS

7 CONTRACTOR'S OR LANDOWNER'S CERTIFICATION: This water well was (1) constructed, (2) reconstructed, or (3) plugged under my jurisdiction and was completed on (mo/day/year) . 4-19-96 . and this record is true to the best of my knowledge and belief. Kansas Water Well Contractor's License No. . 323 . This Water Well Record was completed on (mo/day/yr) . 5-1-96 . under the business name of HOOBLER DRILLING CO. by (signature) Dan Hoobler