

273

Rossville


jd

1 LOCATION OF WATER WELL: Fraction NE SE Section Number 3029 Township Number T 10 S Range Number R 13 E  
 County: Shawnee NW 1/4 SW 1/4 SE 1/4

Distance and direction from nearest town or city street address of well if located within city?  
5521 N.W. Briley Rd or 2 miles NW of Prossville Ks

2 WATER WELL OWNER: Duane Parr Board of Agriculture, Division of Water Resources  
 RR#, St. Address, Box #: 625 Main St Application Number:  
 City, State, ZIP Code: Rossville Kansas 66533

3 LOCATE WELL'S LOCATION WITH AN "X" IN SECTION BOX:

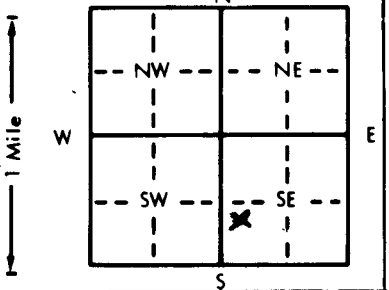

4 DEPTH OF COMPLETED WELL: 50 ft. ELEVATION: 932 RM

Depth(s) Groundwater Encountered 1. 20 ft. 2. . . . . ft. 3. . . . . ft.  
 WELL'S STATIC WATER LEVEL 19 ft. below land surface measured on 6/5/82  
 Pump test data: Well water was 20 ft. after 4 hours pumping 20 gpm  
 Est. Yield 500 gpm: Well water was . . . . . ft. after . . . . . hours pumping . . . . . gpm  
 Bore Hole Diameter: 8 in. to 3.5 ft., and 5 in. to 50 ft.  
 WELL WATER TO BE USED AS:  
 5 Public water supply 8 Air conditioning 11 Injection well  
 1 Domestic 3 Feedlot 6 Oil field water supply 9 Dewatering 12 Other (Specify below)  
 2 Irrigation 4 Industrial 7 Lawn and garden only 10 Observation well  
 Was a chemical/bacteriological sample submitted to Department? Yes . . . . . No X; If yes, mo/day/yr sample was submitted  
 Water Well Disinfected? Yes . . . . . No X

5 TYPE OF BLANK CASING USED:  
 1 Steel 3 RMP (SR) 5 Wrought iron 8 Concrete tile CASING JOINTS: Glued X Clamped . . . . .  
 2 PVC 4 ABS 6 Asbestos-Cement 9 Other (specify below) Welded . . . . .  
 7 Fiberglass Threaded . . . . .

Blank casing diameter 5 in. to 4.3 ft., Dia . . . . . in. to . . . . . ft., Dia . . . . . in. to . . . . . ft.  
 Casing height above land surface 2 in., weight 1.5 lbs./ft. Wall thickness or gauge No. 214

TYPE OF SCREEN OR PERFORATION MATERIAL:  
 1 Steel 3 Stainless steel 5 Fiberglass 6 RMP (SR) 10 Asbestos-cement  
 2 Brass 4 Galvanized steel 6 Concrete tile 9 ABS 12 None used (open hole)  
 11 Other (specify) . . . . .

SCREEN OR PERFORATION OPENINGS ARE:  
 1 Continuous slot 3 Mill slot 5 Gauzed wrapped 8 Saw cut 11 None (open hole)  
 2 Louvered shutter 4 Key punched 6 Wire wrapped 9 Drilled holes  
 7 Torch cut 10 Other (specify) . . . . .

SCREEN-PERFORATED INTERVALS: From 4.3 ft. to 50 ft., From . . . . . ft. to . . . . . ft.  
 From . . . . . ft. to . . . . . ft., From . . . . . ft. to . . . . . ft.

GRAVEL PACK INTERVALS: From . . . . . ft. to . . . . . ft., From . . . . . ft. to . . . . . ft.  
 From . . . . . ft. to . . . . . ft., From . . . . . ft. to . . . . . ft.

6 GROUT MATERIAL: 1 Neat cement 2 Cement grout 3 Bentonite 4 Other . . . . .  
 Grout Intervals: From 0 ft. to 10 ft., From . . . . . ft. to . . . . . ft., From . . . . . ft. to . . . . . ft.

What is the nearest source of possible contamination:  
0 Septic tank 4 Lateral lines 7 Pit privy 14 Abandoned water well  
 2 Sewer lines 5 Cess pool 8 Sewage lagoon 15 Oil well/Gas well  
 3 Watertight sewer lines 6 Seepage pit 9 Feedyard 12 Fertilizer storage 16 Other (specify below)  
 13 Insecticide storage . . . . .

Direction from well? East How many feet? 57

| FROM      | TO        | LITHOLOGIC LOG                  | FROM | TO | LITHOLOGIC LOG |
|-----------|-----------|---------------------------------|------|----|----------------|
| <u>0</u>  | <u>3</u>  | <u>Black Top Soil</u>           |      |    |                |
| <u>3</u>  | <u>20</u> | <u>Lt Brown sand &amp; clay</u> |      |    |                |
| <u>20</u> | <u>29</u> | <u>Quick sand</u>               |      |    |                |
| <u>29</u> | <u>39</u> | <u>Medium Blue sand</u>         |      |    |                |
| <u>39</u> | <u>50</u> | <u>Coarse sand &amp; gravel</u> |      |    |                |
|           |           |                                 |      |    |                |
|           |           |                                 |      |    |                |
|           |           |                                 |      |    |                |
|           |           |                                 |      |    |                |

7 CONTRACTOR'S OR LANDOWNER'S CERTIFICATION: This water well was 1 constructed, (2) reconstructed, or (3) plugged under my jurisdiction and was completed on (mo/day/year) 6/5/82 and this record is true to the best of my knowledge and belief. Kansas Water Well Contractor's License No. 7406 This Water Well Record was completed on (mo/day/yr) 6/8/82 under the business name of Desch Equipment by (signature) [Signature]

INSTRUCTIONS: Use typewriter or ball point pen, PLEASE PRESS FIRMLY and PRINT clearly. Please fill in blanks, underline or circle the correct answers. Send top three copies to Kansas Department of Health and Environment, Division of Environment, Environmental Geology Section, Topeka, KS 66620. Send one to WATER WELL OWNER and retain one for your records.