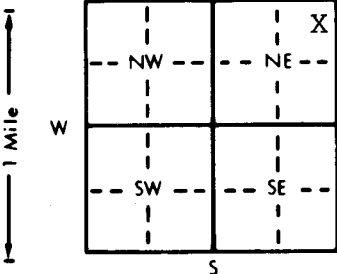


1 LOCATION OF WATER WELL:		Fraction	Section Number	Township Number	Range Number	
County: <u>SHAWNEE</u>		<u>NE 1/4 NE 1/4 NE 1/4</u>	<u>35</u>	<u>T 10 S</u>	<u>R 13 E/W</u>	
Distance and direction from nearest town or city street address of well if located within city? <u>1 1/4 east, 1/2 north of Rossville</u>	
2 WATER WELL OWNER: <u>Bette Thieme</u>	
RR#, St. Address, Box #: <u>7434 N.W. 74th</u> <u>EAST LOT, PIPE TO MIDDLE LOT</u> Board of Agriculture, Division of Water Resources	
City, State, ZIP Code: <u>Topeka, KS 66618</u> Application Number: _____	
3 LOCATE WELL'S LOCATION WITH AN "X" IN SECTION BOX:		4 DEPTH OF COMPLETED WELL: <u>200'</u> ft. ELEVATION: _____ ft.	
<div style="text-align: center;"></div>		Depth(s) Groundwater Encountered 1. <u>65'</u> ft. 2. _____ ft. 3. _____ ft.	
		WELL'S STATIC WATER LEVEL <u>48'</u> ft. below land surface measured on mo/day/yr <u>05/13/98</u>	
		Pump test data: Well water was _____ ft. after _____ hours pumping _____ gpm	
		Est. Yield <u>25 GPH</u> gpm: Well water was _____ ft. after _____ hours pumping _____ gpm	
Bore Hole Diameter <u>8 3/4</u> in. to _____ ft., and _____ in. to _____ ft.	
WELL WATER TO BE USED AS:	
1 Domestic 3 Feedlot 6 Oil field water supply 9 Dewatering 12 Other (Specify below)	
2 Irrigation 4 Industrial 7 Lawn and garden only 10 Monitoring well	
Was a chemical/bacteriological sample submitted to Department? Yes _____ No <u>X</u> If yes, mo/day/yr sample was submitted _____	
Water Well Disinfected? Yes <u>X</u> No _____	
5 TYPE OF BLANK CASING USED:	
1 Steel 3 RMP (SR) 5 Wrought iron 8 Concrete tile CASING JOINTS: Glued <u>X</u> Clamped _____	
2 PVC 4 ABS 6 Asbestos-Cement 9 Other (specify below) Welded _____	
3 Fiberglass Threaded _____	
Blank casing diameter <u>5"</u> in. to <u>0-60</u> ft., Dia <u>5"</u> in. to <u>120-200</u> ft., Dia _____ in. to _____ ft.	
Casing height above land surface <u>24'</u> in., weight <u>2.82</u> lbs./ft. Wall thickness or gauge No. <u>.258</u>	
TYPE OF SCREEN OR PERFORATION MATERIAL:	
1 Steel 3 Stainless steel 5 Fiberglass 7 PVC 10 Asbestos-cement	
2 Brass 4 Galvanized steel 6 Concrete tile 8 RMP (SR) 11 Other (specify) _____	
3 ABS 12 None used (open hole)	
SCREEN OR PERFORATION OPENINGS ARE:	
1 Continuous slot 3 Mill slot 5 Gauzed wrapped 8 Saw cut 11 None (open hole)	
2 Louvered shutter 4 Key punched 6 Wire wrapped 9 Drilled holes	
7 Torch cut 10 Other (specify) _____	
SCREEN-PERFORATED INTERVALS: From <u>60</u> ft. to <u>120</u> ft., From _____ ft. to _____ ft.	
From _____ ft. to _____ ft., From _____ ft. to _____ ft.	
GRAVEL PACK INTERVALS: From <u>24</u> ft. to <u>200</u> ft., From _____ ft. to _____ ft.	
From _____ ft. to _____ ft., From _____ ft. to _____ ft.	
6 GROUT MATERIAL: 1 Neat cement 2 Cement grout 3 Bentonite 4 Other _____	
Grout intervals: From <u>4</u> ft. to <u>24</u> ft., From _____ ft. to _____ ft., From _____ ft. to _____ ft.	
What is the nearest source of possible contamination:	
1 Septic tank 4 Lateral lines 7 Pit privy 10 Livestock pens 14 Abandoned water well	
2 Sewer lines 5 Cess pool 8 Sewage lagoon 11 Fuel storage 15 Oil well/Gas well	
3 Watertight sewer lines 6 Seepage pit 9 Feedyard 12 Fertilizer storage 16 Other (specify below) _____	
13 Insecticide storage _____	
Direction from well? <u>west</u> How many feet? <u>420'</u>	
<table border="1" style="width:100%; border-collapse: collapse;"><thead><tr><th>FROM</th><th>TO</th><th>LITHOLOGIC LOG</th><th>FROM</th><th>TO</th><th>PLUGGING INTERVALS</th></tr></thead><tbody><tr><td>0</td><td>4</td><td>Clay-Brown</td><td>127</td><td>129</td><td>Limestone-Grey</td></tr><tr><td>4</td><td>7</td><td>Gravel, Boulders-Clay-Brown</td><td>129</td><td>138</td><td>Shale-Grey</td></tr><tr><td>7</td><td>23</td><td>Shale-Yellow</td><td>138</td><td>159</td><td>Limestone-Grey</td></tr><tr><td>23</td><td>36</td><td>Shale-Grey</td><td>159</td><td>162</td><td>Shaley LS-Grey</td></tr><tr><td>36</td><td>39</td><td>Limestone-Tan</td><td>162</td><td>167</td><td>Limestone-Grey</td></tr><tr><td>39</td><td>49</td><td>Shale-Grey</td><td>167</td><td>171</td><td>Shale-Red</td></tr><tr><td>49</td><td>55</td><td>Limestone-Tan</td><td>171</td><td>175</td><td>Shale-Grey</td></tr><tr><td>55</td><td>65</td><td>Shale-Grey</td><td>175</td><td>182</td><td>Shaley LS-Grey</td></tr><tr><td>65</td><td>67</td><td>Sandstone-Grey</td><td>182</td><td>200</td><td>Shale-Grey</td></tr><tr><td>67</td><td>71</td><td>Sandy Shale-Grey</td><td></td><td></td><td></td></tr><tr><td>71</td><td>73</td><td>Sandstone-Grey</td><td></td><td></td><td></td></tr><tr><td>73</td><td>110</td><td>Shale-Grey</td><td></td><td></td><td></td></tr><tr><td>110</td><td>115</td><td>Limestone-Grey</td><td></td><td></td><td></td></tr><tr><td>115</td><td>120</td><td>Shaley LS-Grey</td><td></td><td></td><td></td></tr><tr><td>120</td><td>127</td><td>Shale-Grey</td><td></td><td></td><td></td></tr>
7 CONTRACTOR'S OR LANDOWNER'S CERTIFICATION: This water well was (1) constructed, (2) reconstructed, or (3) plugged under my jurisdiction and was completed on (mo/day/year) <u>05/13/98</u> and this record is true to the best of my knowledge and belief. Kansas Water Well Contractor's License No. <u>182</u> This Water Well Record was completed on (mo/day/yr) <u>6-3-98</u> under the business name of <u>STRADER DRILLING CO., INC.</u> by (signature) <u>Dale Asbran</u>	