


1 LOCATION OF WATER WELL: Fraction Section Number Township Number Range Number
 County: **Shawnee** **NW NW SE** **24** **10S** **13E** **(E/W)**

Distance and direction from nearest town or city street address of well if located within city?
Van Wood Cardloc site; 117 US Hwy 24, Rossville, Ks

2 WATER WELL OWNER: **Dick Wood**
 RR #, St. Address, Box #: **13841 NW 54th Street** Board of Agriculture, Division of Water Resources
 City, State, ZIP Code: **Rossville, Ks 66533** Application Number:

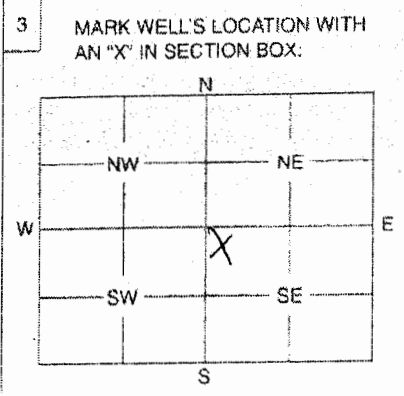

4 DEPTH OF WELL **22** ft.
 WELL'S STATIC WATER LEVEL **22** ft.
 WELL WAS USED AS:
 1 Domestic 2 Irrigation 3 Feedlot 4 Industrial 5 Public Water Supply 6 Oil Field Water Supply 7 Domestic (Lawn & Garden) 8 Air Conditioning 9 Dewatering 10 **Monitoring Well** 11 Injection Well 12 Other
 Was a chemical / bacteriological sample submitted to Department? Yes No **X**
 If yes, mo/day/yr sample was submitted
 Water Well Disinfected: Yes No **X**

5 TYPE OF BLANK CASING USED:
 1 Steel 2 PVC **(2)** 3 RMP (SR) 4 ABS 5 Wrought 6 Asbestos-Cement 7 Fiberglass 8 Concrete Tile 9 Other (Specify below)
 Blank casing diameter in. Was casing pulled? Yes **X** No If yes, how much **NA**
 Casing height above or below land surface in.

6 GROUT PLUG MATERIAL: **3** Neat cement **2** Cement grout **3** Bentonite **4** Other **Surface silts and clays**
 Grout Plug Intervals: From **22** ft. to **1** ft. From **1** ft. to **0** ft. From to ft.
 What is the nearest source of possible contamination:
 1 Septic tank 2 Sewer lines 3 Watertight sewer lines 4 Lateral lines 5 Cess pool 6 Seepage pit 7 Pit privy 8 Sewage lagoon 9 Feedyard 10 Livestock pens 11 Fuel storage 12 Fertilizer storage 13 Insecticide storage 14 Abandoned water well 15 Oil well/Gas well **16 Other (specify below) cont. site**
 Direction from well? How many feet?

FROM	TO	PLUGGING MATERIALS
22	1	Bentonite
1	0	Surface silts/clays

7 CONTRACTOR'S OF LANDOWNER'S CERTIFICATION: This water well was plugged under my jurisdiction and was completed on (mo/day/year) **10/11/07** and this record is true to the best of my knowledge and belief. Kansas Water Well Contractor's License No **585** This Water Well Record was completed on (mo/day/year) **10/22/07** under the business name of **Associated Environmental, Inc.** by (signature) **B. Johnson**

INSTRUCTIONS: Use typewriter or ball point pen. Please press firmly and print clearly. Please fill in blanks, underline or circle the correct answers. Send top three copies to Kansas Department of Health and Environment, Bureau of Water, Geology Section, 1000 SW Jackson St., Ste 420, Topeka, Kansas 66612-1367. Telephone: 785/296-5522. Send one to Water Well Owner and retain one for your records.