


1	LOCATION OF WATER WELL: County: <b>Shawnee</b>	Fraction <b>NW NW 1/4 SE 1/4</b>	Section Number <b>24</b>	Township Number <b>10S</b>	Range Number <b>13E</b>
---	---	-------------------------------------	-----------------------------	-------------------------------	----------------------------

Distance and direction from nearest town or city street address of well if located within city?  
**Van Wood Cardloc site; 117 US Hwy 24, Rossville, Ks**

2	WATER WELL OWNER: <b>Dick Wood</b> RR #, St. Address, Box #: <b>13841 NW 54th Street</b> City, State, ZIP Code: <b>Rossville, Ks 66533</b>	Board of Agriculture, Division of Water Resources Application Number:
---	--	--

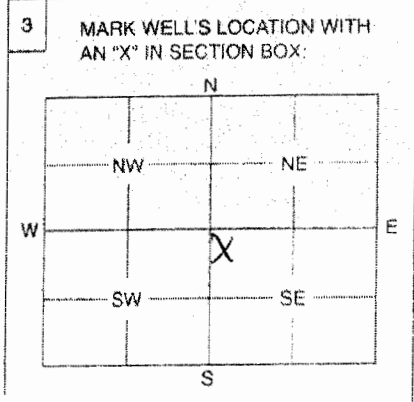

4 DEPTH OF WELL ..... **18** ..... ft.  
 WELL'S STATIC WATER LEVEL **dry** ..... ft.  
 WELL WAS USED AS:  
 1 Domestic                      5 Public Water Supply                      9 Dewatering  
 2 Irrigation                      6 Oil Field Water Supply                      10  Monitoring Well  
 3 Feedlot                          7 Domestic (Lawn & Garden)                      11 Injection Well  
 4 Industrial                      8 Air Conditioning                          12 Other .....

Was a chemical / bacteriological sample submitted to Department? Yes ..... No  .....  
 If yes, mo/day/yr sample was submitted .....

Water Well Disinfected: Yes ..... No  .....

5 TYPE OF BLANK CASING USED:  
 Steel     RMP (SR)     Wrought     Fiberglass     Other (Specify below)  
 PVC     ABS     Asbestos-Cement     Concrete Tile

Blank casing diameter **2** in.    Was casing pulled? Yes  No ..... If yes, how much **NA** .....  
 Casing height above or below land surface ..... in.

6 GROUT PLUG MATERIAL:  Neat cement     Cement grout     Bentonite     Other: **Surface silts and clays**

Grout Plug Intervals: From **18** ft. to **1** ft.    From **1** ft. to **0** ft.    From ..... to ..... ft.

What is the nearest source of possible contamination:  
 1 Septic tank    6 Seepage pit    11 Fuel storage    16 Other (specify below) **cont. site**  
 2 Sewer lines    7 Pit privy    12 Fertilizer storage  
 3 Watertight sewer lines    8 Sewage lagoon    13 Insecticide storage  
 4 Lateral lines    9 Feedyard    14 Abandoned water well  
 5 Cess pool    10 Livestock pens    15 Oil well/Gas well

Direction from well? ..... How many feet? .....

FROM	TO	PLUGGING MATERIALS
18	1	Bentonite
1	0	Surface silts/clays

7 CONTRACTOR'S OF LANDOWNER'S CERTIFICATION. This water well was plugged under my jurisdiction and was completed on (mo/day/year) **10/11/07** and this record is true to the best of my knowledge and belief. Kansas Water Well Contractor's License No. **585** This Water Well Record was completed on (mo/day/year) **10/22/07** under the business name of **Associated Environmental, Inc.** by (signature) **B. Johnson**

INSTRUCTIONS: Use typewriter or ball point pen. Please press firmly and print clearly. Please fill in blanks, underline or circle the correct answers. Send top three copies to Kansas Department of Health and Environment, Bureau of Water, Geology Section, 1000 SW Jackson St., Ste. 420, Topeka, Kansas 66612-1367. Telephone: 785/296-5522. Send one to Water Well Owner and retain one for your records.