


1 LOCATION OF WATER WELL: County: Shawnee Fraction NE 1/4 SE 1/4 Section Number 15 Township Number T 10 S Range Number R 13 E/W

Distance and direction from nearest town or city street address of well if located within city? From Rosville Go 1 mile north on main thin 60 1/2 mile on 62nd thin 60 North 1 mile on Carlson Rd & to west

2 WATER WELL OWNER: David Ronnbaum  
 RR#, St. Address, Box #: 5521 N.W. Bailey Rd.  
 City, State, ZIP Code: Rossville, Kansas 66533  
 Board of Agriculture, Division of Water Resources  
 Application Number:

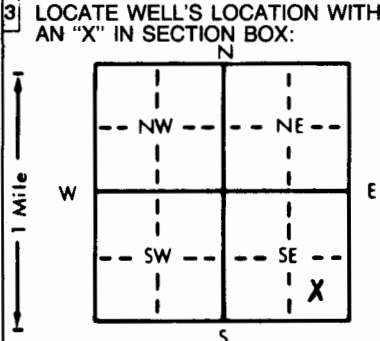

4 DEPTH OF COMPLETED WELL: 38' ft. ELEVATION:  
 Depth(s) Groundwater Encountered 1. 20' ft. 2. . ft. 3. . ft.  
 WELL'S STATIC WATER LEVEL 20' ft. below land surface measured on mo/day/yr  
 Pump test data: Well water was . ft. after . hours pumping . gpm  
 Est. Yield 1.5 gpm: Well water was . ft. after . hours pumping . gpm  
 Bore Hole Diameter: 8 in. to 40 in. to . in. to . ft.  
 WELL WATER TO BE USED AS:  
 1 Domestic (circled) 3 Feedlot 6 Oil field water supply 9 Dewatering 12 Other (Specify below)  
 2 Irrigation 4 Industrial 7 Lawn and garden only 10 Monitoring well  
 Was a chemical/bacteriological sample submitted to Department? Yes. . No. . If yes, mo/day/yr sample was submitted  
 Water Well Disinfected Yes (checked) No

5 TYPE OF BLANK CASING USED:  
 1 Steel (circled) 3 RMP (SR) 5 Wrought iron 8 Concrete tile CASING JOINTS: Glued (checked) Clamped .  
 2 PVC (circled) 4 ABS 6 Asbestos-Cement 9 Other (specify below) Welded: Sealed  
 7 Fiberglass Threaded .  
 Blank casing diameter 5" in. to 20 ft., Dia. . in. to . ft., Dia. . in. to . ft.  
 Casing height above land surface 2' in., weight Sch. 40 lbs./ft. Wall thickness or gauge No. .  
 TYPE OF SCREEN OR PERFORATION MATERIAL:  
 1 Steel 3 Stainless steel 5 Fiberglass 8 RMP (SR) 10 Asbestos-cement  
 2 Brass 4 Galvanized steel 6 Concrete tile 9 ABS 11 Other (specify) .  
 12 None used (open hole)  
 SCREEN OR PERFORATION OPENINGS ARE: 31 1900s  
 1 Continuous slot 3 Mill slot (circled) 5 Gauzed wrapped 8 Saw cut 11 None (open hole)  
 2 Louvered shutter 4 Key punched 6 Wire wrapped 9 Drilled holes  
 7 Torch cut 10 Other (specify) .  
 SCREEN-PERFORATED INTERVALS: From 20 ft. to 40 ft., From . ft. to . ft.  
 From . ft. to . ft., From . ft. to . ft.  
 GRAVEL PACK INTERVALS: From 20 ft. to 40 ft., From . ft. to . ft.  
 From . ft. to . ft., From . ft. to . ft.

6 GROUT MATERIAL: 1 Neat cement 2 Cement grout 3 Bentonite (circled) 4 Other .  
 Grout Intervals: From 0 ft. to 20 ft., From . ft. to ENVIRONMENTAL ft., From . ft. to . ft.  
 What is the nearest source of possible contamination: None Close  
 1 Septic tank 4 Lateral lines 7 Pit privy 10 Livestock pens 14 Abandoned water well  
 2 Sewer lines 5 Cess pool 8 Sewage lagoon 11 Fuel storage 15 Oil well/Gas well  
 3 Watertight sewer lines 6 Seepage pit 9 Feedyard 12 Fertilizer storage 16 Other (specify below)  
 13 Insecticide storage  
 Direction from well? How many feet?

FROM	TO	LITHOLOGIC LOG	FROM	TO	PLUGGING INTERVALS
0	21	Brown clay			
21	27	Brown clay & gravel			
27	40	Grey shale			

7 CONTRACTOR'S OR LANDOWNER'S CERTIFICATION: This water well was (1) constructed (2) reconstructed, or (3) plugged under my jurisdiction and was completed on (mo/day/year) 10/20/88 and this record is true to the best of my knowledge and belief. Kansas Water Well Contractor's License No. 451 This Water Well Record was completed on (mo/day/yr) 11/11/88 under the business name of Holden Well Drilling by (signature) Craig H.

INSTRUCTIONS: Use typewriter or ball point pen. PLEASE PRESS FIRMLY and PRINT clearly. Please fill in blanks, underline or circle the correct answers. Send top three copies to Kansas Department of Health and Environment, Bureau of Water Protection, Topeka, Kansas 66620-7320. Telephone: 913-296-5514. Send one to WATER WELL OWNER and retain one for your records.