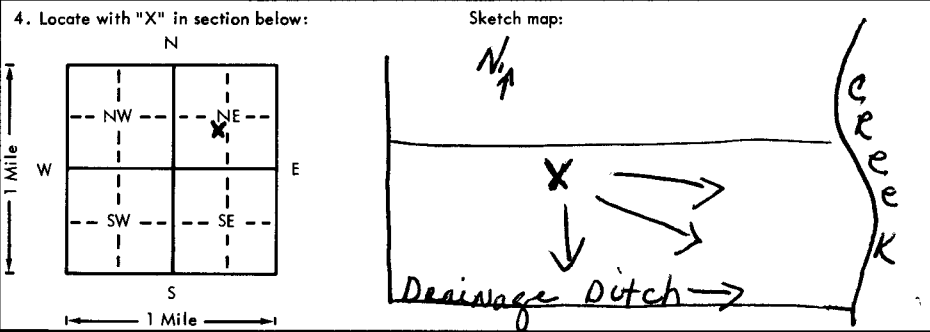


USE TYPEWRITER OR BALL
POINT PEN-PRESS FIRMLY,
PRINT CLEARLY.

WATER WELL RECORD
KSA 82a-1201-1215

Kansas Department of Health and
Environment-Division of Environment
(Water well Contractors)
Topeka, Kansas 66620

1. Location of well:	County Shawnee	Fraction NE 1/4 SW 1/4 NE 1/4	Section number 28	Township number T 10S	Range number R 13E	E/W
2. Distance and direction from nearest town or city: 1 1/2 mi. West of Rossville, Ks. on U.S. 24 Street address of well location if in city:			3. Owner of well: Raymond P. Murray R.R. or street: E.E. Navy School City, state, zip code: Monterrey, Calif. 93940			
4. Locate with "X" in section below: 			6. Bore hole dia. 30 in. Completion date 3-8-77 Well depth 64 ft.			
5. Type and color of material			7. <input type="checkbox"/> Cable tool <input type="checkbox"/> Rotary <input type="checkbox"/> Driven <input type="checkbox"/> Dug <input type="checkbox"/> Hollow rod <input type="checkbox"/> Jetted <input type="checkbox"/> Bored <input checked="" type="checkbox"/> Reverse rotary			
			8. Use: <input type="checkbox"/> Domestic <input type="checkbox"/> Public supply <input type="checkbox"/> Industry <input checked="" type="checkbox"/> Irrigation <input type="checkbox"/> Air conditioning <input type="checkbox"/> Stock <input type="checkbox"/> Lawn <input type="checkbox"/> Oil field water <input type="checkbox"/> Other			
			9. Casing: Material Trans Height: 12 ft. Threaded <input type="checkbox"/> Welded <input type="checkbox"/> Surface <input type="checkbox"/> in. RMP <input type="checkbox"/> PVC <input type="checkbox"/> Weight <input type="checkbox"/> lbs./ft. Dia. 16 in. to 38 ft. depth Wall Thickness: inches or Dia. <input type="checkbox"/> in. to <input type="checkbox"/> ft. depth gage No. 7/8			
			10. Screen: Manufacturer's name Johnson Well Co. Type Transite Dia. 16" (Slot) gauze 1/8x8 Length 26' Set between 64 ft. and 38 ft. <input type="checkbox"/> ft. and <input type="checkbox"/> ft. Gravel pack? yes Size range of material 5/8			
			11. Static water level: 22.8 ft. below land surface Date 12-31-76 mo./day/yr.			
			12. Pumping level below land surfaces: 27 ft. after 1 hrs. pumping 1000 g.p.m. 32.4 ft. after 3 hrs. pumping 1250 g.p.m. Estimated maximum yield 1500 g.p.m.			
			13. Water sample submitted: <input type="checkbox"/> Yes <input checked="" type="checkbox"/> No Date 12-19-76 mo./day/yr.			
			14. Well head completion: <input type="checkbox"/> Pitless adapter <input type="checkbox"/> Inches above grade			
			15. Well grouted? yes With: <input type="checkbox"/> Neat cement <input type="checkbox"/> Bentonite <input checked="" type="checkbox"/> Concrete Depth: From 0 ft. to 10 ft.			
			16. Nearest source of possible contamination: 2000 ft. Direction east Type creek Well disinfected upon completion? <input type="checkbox"/> Yes <input checked="" type="checkbox"/> No			
			17. Pump: <input checked="" type="checkbox"/> Not installed Manufacturer's name _____ Model number _____ HP _____ Volts _____ Length of drop pipe _____ ft. capacity _____ g.p.m. Type: <input type="checkbox"/> Submersible <input type="checkbox"/> Turbine <input type="checkbox"/> Jet <input type="checkbox"/> Reciprocating <input type="checkbox"/> Centrifugal <input type="checkbox"/> Other			
18. Elevation: 207' Topography: <input type="checkbox"/> Hill <input type="checkbox"/> Slope <input type="checkbox"/> Upland <input checked="" type="checkbox"/> Valley			19. Remarks: We do not install pumps.			
			20. Water well contractor's certification: This well was drilled under my jurisdiction and this report is true to the best of my knowledge and belief. Hoobler Drilling Co. 323 Business name License No. Address St. Marys, Ks. 66536 Signed Don Halibur Date 3-14-77 Authorized representative			

Forward the white, blue and pink copies to the Department of Health and Environment

Form WWC-5

BR < 863

∇ = 904