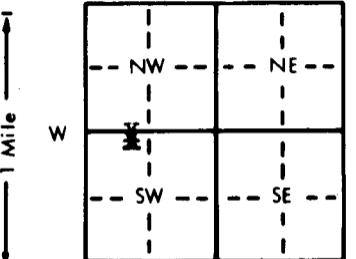


1 LOCATION OF WATER WELL: County: Shawnee		FRACTION NE 1/4 NW 1/4 SW 1/4		SECTION NUMBER 28		TOWNSHIP NUMBER T 10 S		RANGE NUMBER R 13 EW	
Distance and direction from nearest town or city street address of well if located within city? 200 ft. N. of original well									
2 WATER WELL OWNER: Irene B. Campbell RR#, St. Address, Box # : Rt. 1 City, State, ZIP Code : Rossville, KS 66533 Board of Agriculture, Division of Water Resources Application Number: 2391									
3 LOCATE WELL'S LOCATION WITH AN "X" IN SECTION BOX: 			4 DEPTH OF COMPLETED WELL: 80 ft. ELEVATION: Depth(s) Groundwater Encountered 1. 18 ft. 2. ft. 3. ft. WELL'S STATIC WATER LEVEL 18 ft. below land surface measured on mo/day/yr 8-25-84 Pump test data: Well water was 29 ft. after 1 hours pumping 1000 gpm Est. Yield 1500 gpm: Well water was 37 ft. after 2 hours pumping 1200 gpm Bore Hole Diameter ... 32 in. to 80 ft., and in. to ft. WELL WATER TO BE USED AS: 5 Public water supply 8 Air conditioning 11 Injection well 1 Domestic 3 Feedlot 6 Oil field water supply 9 Dewatering 12 Other (Specify below) 2 Irrigation 4 Industrial 7 Lawn and garden only 10 Observation well Was a chemical/bacteriological sample submitted to Department? Yes..... No... X If yes, mo/day/yr sample was submitted Water Well Disinfected? Yes No X						
5 TYPE OF BLANK CASING USED: 1 Steel 3 RMP (SR) 5 Wrought iron 8 Concrete tile CASING JOINTS: Glued Clamped X 2 PVC 4 ABS 6 Asbestos-Cement 9 Other (specify below) Welded Blank casing diameter 16 in. to 59 ft., Dia in. to ft., Dia in. to ft. Casing height above land surface 12 in., weight lbs./ft. Wall thickness or gauge No. 7.50 TYPE OF SCREEN OR PERFORATION MATERIAL: 7 PVC 10 Asbestos-cement 1 Steel 3 Stainless steel 5 Fiberglass 8 RMP (SR) 11 Other (specify) 2 Brass 4 Galvanized steel 6 Concrete tile 9 ABS 12 None used (open hole) SCREEN OR PERFORATION OPENINGS ARE: 5 Gauzed wrapped 8 Saw cut 11 None (open hole) 1 Continuous slot 3 Mill slot 6 Wire wrapped 9 Drilled holes 2 Louvered shutter 4 Key punched 7 Torch cut 10 Other (specify) SCREEN-PERFORATED INTERVALS: From 59 ft. to 80 ft., From ft. to ft. GRAVEL PACK INTERVALS: From 10 ft. to 80 ft., From ft. to ft. From ft. to ft., From ft. to ft.									
6 GROUT MATERIAL: 1 Neat cement 2 Cement grout 3 Bentonite 4 Other Grout Intervals: From 0 ft. to 10 ft., From ft. to ft., From ft. to ft. What is the nearest source of possible contamination: 1 Septic tank 4 Lateral lines 7 Pit privy 10 Livestock pens 14 Abandoned water well 2 Sewer lines 5 Cess pool 8 Sewage lagoon 11 Fuel storage 15 Oil well/Gas well 3 Watertight sewer lines 6 Seepage pit 9 Feedyard 12 Fertilizer storage 16 Other (specify below) 13 Insecticide storage NONE Direction from well? How many feet? FROM TO LITHOLOGIC LOG FROM TO LITHOLOGIC LOG 0 4 Black Silt 4 22 Hard brown silt 22 25 Sm Wht creek gravel & black silt 25 80 med.- lg. brown gravel 80 Hard gray shale STOPPED									
7 CONTRACTOR'S OR LANDOWNER'S CERTIFICATION: This water well was (1) constructed (2) reconstructed or (3) plugged under my jurisdiction and was completed on (mo/day/year) 7-23-84 and this record is true to the best of my knowledge and belief. Kansas Water Well Contractor's License No. 323 This Water Well Record was completed on (mo/day/yr) 12-22-84 under the business name of Hoobler Drilling Company by (signature) Daniel R. Hoobler INSTRUCTIONS: Use typewriter or ball point pen, PLEASE PRESS FIRMLY and PRINT clearly. Please fill in blanks, underline or circle the correct answers. Send top three copies to Kansas Department of Health and Environment, Division of Environment, Environmental Geology Section, Topeka, KS 66620. Send one to WATER WELL OWNER and retain one for your records.									