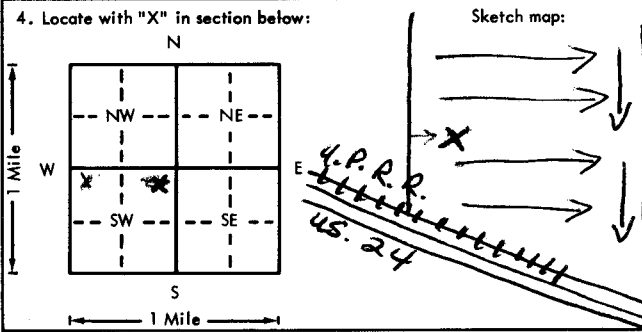


10

USE TYPEWRITER OR BALL
POINT PEN-PRESS FIRMLY,
PRINT CLEARLY.

WATER WELL RECORD
KSA 82a-1201-1215

Kansas Department of Health and
Environment-Division of Environment
(Water well Contractors)
Topeka, Kansas 66620

1. Location of well: County Shawnee		Fraction NW 1/4 NE 1/4 SW 1/4	Section number 28	Township number T 10S	Range number S R 13E
2. Distance and direction from nearest town or city: 1 1/2 mi. West of Rossville, Ks. on U.S. 24 Street address of well location if in city:			3. Owner of well: David Stadler R.R. or street: City, state, zip code: Rossville, Kansas 66533		
4. Locate with "X" in section below: 			6. Bore hole dia. 30 in. Completion date 3-8-77 Well depth 65 ft.		
5. Type and color of material			7. <input type="checkbox"/> Cable tool <input type="checkbox"/> Rotary <input type="checkbox"/> Driven <input type="checkbox"/> Dug <input type="checkbox"/> Hollow rod <input type="checkbox"/> Jetted <input checked="" type="checkbox"/> Bored <input checked="" type="checkbox"/> Reverse rotary		
Black gumbo			8. Use: <input type="checkbox"/> Domestic <input type="checkbox"/> Public supply <input type="checkbox"/> Industry <input checked="" type="checkbox"/> Irrigation <input type="checkbox"/> Air conditioning <input type="checkbox"/> Stock <input type="checkbox"/> Lawn <input type="checkbox"/> Oil field water <input type="checkbox"/> Other		
Lt. brown silt			9. Casing: Material Transite Height (Above or below Threaded <input type="checkbox"/> Welded <input type="checkbox"/> Surface <input type="checkbox"/> 12 in. RMP <input type="checkbox"/> PVC <input type="checkbox"/> Weight <input type="checkbox"/> lbs./ft. Dia. 16 in. to 39 ft. depth Wall Thickness: inches or Dia. <input type="checkbox"/> in. to <input type="checkbox"/> ft. depth gage No. 7/8		
Med. to large brown gravel			10. Screen: Manufacturer's name Johnson Well Co. Type Transite Dia. 16" Slot/gauze 1/8x8 Length 26" Set between 39 ft. and 65 ft. ft. and <input type="checkbox"/> ft. Gravel pack? yes Size range of material 5/8		
Soft brown silt & fine sand			11. Static water level: <input type="checkbox"/> mo./day/yr. 23 ft. below land surface Date 1-3-77		
Med. to large brown sand			12. Pumping level below land surfaces: 27 ft. after 1 hrs. pumping 1000 g.p.m. 32 ft. after 3 hrs. pumping 1250 g.p.m. Estimated maximum yield 1500 g.p.m.		
Gray clay & med. green gravel			13. Water sample submitted: <input type="checkbox"/> mo./day/yr. <input type="checkbox"/> Yes <input checked="" type="checkbox"/> No Date <input type="checkbox"/>		
Fine to med. brown gravel			14. Well head completion: <input type="checkbox"/> Pitless adapter <input type="checkbox"/> Inches above grade		
Large gravel			15. Well grouted? yes With: <input type="checkbox"/> Neat cement <input type="checkbox"/> Bentonite <input checked="" type="checkbox"/> Concrete Depth: From 0 ft. to 10 ft.		
Stopped-large rocks.			16. Nearest source of possible contamination: ft. 800 Direction South Type R.R. track Well disinfected upon completion? <input type="checkbox"/> Yes <input checked="" type="checkbox"/> No		
(Use a second sheet if needed)			17. Pump: <input checked="" type="checkbox"/> Not installed Manufacturer's name <input type="checkbox"/> Model number <input type="checkbox"/> HP <input type="checkbox"/> Volts <input type="checkbox"/> Length of drop pipe <input type="checkbox"/> ft. capacity <input type="checkbox"/> g.p.m. Type: <input type="checkbox"/> Submersible <input type="checkbox"/> Turbine <input type="checkbox"/> Jet <input type="checkbox"/> Reciprocating <input type="checkbox"/> Centrifugal <input type="checkbox"/> Other		
18. Elevation: 927 Topography: <input type="checkbox"/> Hill <input type="checkbox"/> Slope <input type="checkbox"/> Upland <input checked="" type="checkbox"/> Valley		19. Remarks: We do not install pumps. 927 (from well)			
20. Water well contractor's certification: This well was drilled under my jurisdiction and this report is true to the best of my knowledge and belief. Hoobler Drilling Co. 323 Business name License No. Address St. Marys, Ks. 66536 Signed Don Stadler 3-14-77 Authorized representative					

Forward the white, blue and pink copies to the Department of Health and Environment

Form WWC-5

BR < 862

$\nabla = 904$