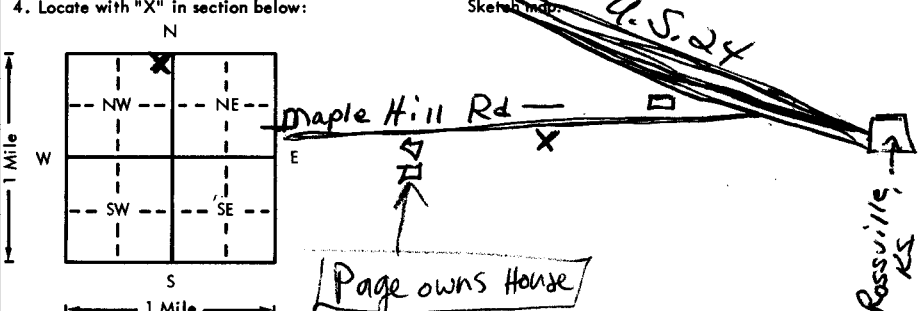


USE TYPEWRITER OR BALL
POINT PEN-PRESS FIRMLY,
PRINT CLEARLY.

WATER WELL RECORD
KSA 82a-1201-1215

Kansas Department of Health and
Environment-Division of Environment
(Water well Contractors)
Topeka, Kansas 66620

1. Location of well:		County Shawnee	Fraction NE 1/4 NE 1/4 NW 1/4	Section number 33	Township number T 10	Range number S R 13
2. Distance and direction from nearest town or city: 1 1/2 mi. West of Rossville, Ks. on U.S. 24 & 1/4 mi. W. on Maple Hill Rd.				3. Owner of well: Fred Heiland R.R. or street: R. R. #6 City, state, zip code: Topeka, Kansas		
4. Locate with "X" in section below: 				6. Bore hole dia. 30 in. Completion date 11-2-76 Well depth 80 ft.		
5. Type and color of material				7. <input type="checkbox"/> Cable tool <input type="checkbox"/> Rotary <input type="checkbox"/> Driven <input type="checkbox"/> Dug <input type="checkbox"/> Hollow rod <input type="checkbox"/> Jetted <input type="checkbox"/> Bored <input checked="" type="checkbox"/> Reverse rotary		
Black top soil				8. Use: <input checked="" type="checkbox"/> Domestic <input type="checkbox"/> Public supply <input type="checkbox"/> Industry <input checked="" type="checkbox"/> Irrigation <input type="checkbox"/> Air conditioning <input type="checkbox"/> Stock <input type="checkbox"/> Lawn <input type="checkbox"/> Oil field water <input type="checkbox"/> Other		
Brown sandy clay loam				9. Casing: Material Transite Height (Above or below) 12 in. Threaded <input type="checkbox"/> Welded <input type="checkbox"/> Surface <input type="checkbox"/> RMP <input type="checkbox"/> PVC <input type="checkbox"/> Weight <input type="checkbox"/> lbs./ft. Dia. 16 in. to 39 ft. depth Wall Thickness: inches or Dia. <input type="checkbox"/> in. to <input type="checkbox"/> ft. depth gage No. 5/8		
Hard brown silt				10. Screen: Manufacturer's name Johnson Well Co. Type Transite Dia. 16" Slot/gauze 1/8x8 Length 39' MAC Set between 80 ft. and 41 ft. ft. and <input type="checkbox"/> ft. Gravel pack? yes Size range of material 5/8		
Fine brown sand				11. Static water level: <input type="checkbox"/> mo./day/yr. 21 ft. below land surface Date 11-2-76		
Med. to small brown gravel				12. Pumping level below land surfaces: 25 ft. after 1 hrs. pumping 1000 g.p.m. 27 ft. after 3 hrs. pumping 1200 g.p.m. Estimated maximum yield 1500 g.p.m.		
Med. to large brown gravel				13. Water sample submitted: <input type="checkbox"/> mo./day/yr. <input type="checkbox"/> Yes <input checked="" type="checkbox"/> No Date <input type="checkbox"/>		
Fine brown sand				14. Well head completion: <input type="checkbox"/> Pitless adapter <input type="checkbox"/> Inches above grade		
Med. brown gravel				15. Well grouted? yes With: <input type="checkbox"/> Neat cement <input type="checkbox"/> Bentonite <input checked="" type="checkbox"/> Concrete Depth: From 0 ft. to 11 ft.		
Stopped				16. Nearest source of possible contamination: ft. 1000 Direction North Type Ditch Well disinfected upon completion? <input type="checkbox"/> Yes <input checked="" type="checkbox"/> No		
(Use a second sheet if needed)				17. Pump: <input checked="" type="checkbox"/> Not installed Manufacturer's name <input type="checkbox"/> Model number <input type="checkbox"/> HP <input type="checkbox"/> Volts <input type="checkbox"/> Length of drop pipe <input type="checkbox"/> ft. capacity <input type="checkbox"/> g.p.m. Type: <input type="checkbox"/> Submersible <input type="checkbox"/> Turbine <input type="checkbox"/> Jet <input type="checkbox"/> Reciprocating <input type="checkbox"/> Centrifugal <input type="checkbox"/> Other		
18. Elevation: 725 Topography: <input type="checkbox"/> Hill <input type="checkbox"/> Slope <input checked="" type="checkbox"/> Upland <input type="checkbox"/> Valley		19. Remarks: We do not install pumps.		20. Water well contractor's certification: This well was drilled under my jurisdiction and this report is true to the best of my knowledge and belief. Hoobler Drilling Co. 323 Business name License No. Address St. Marys, Ks. 66536 Signed Dan Hoobler Date 11-9-76 Authorized representative		

Forward the white, blue and pink copies to the Department of Health and Environment

Form WWC-5