

1 LOCATION OF WATER WELL:	Fraction	Section Number	Township Number	Range Number
County: <u>SHAWNEE</u>	<u>SW 1/4 SE 1/4 SWE 1/4</u>	<u>34</u>	<u>T 10 S</u>	<u>R 13 E/W</u>

Distance and direction from nearest town or city street address of well if located within city:

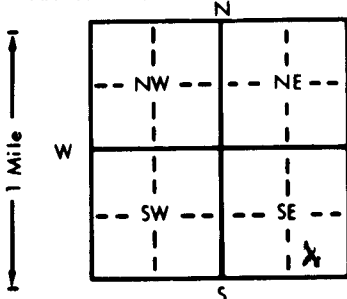
SE EDGE MOSSKILL

2 WATER WELL OWNER:	<u>UNIFIED SCHOOL DIST. 321</u>
RR#, St. Address, Box #	<u>ST. MARYS KS. 66536</u>
City, State, ZIP Code	

Board of Agriculture, Division of Water Resources

Application Number: 39,932

3 LOCATE WELL'S LOCATION WITH AN "X" IN SECTION BOX:	4 DEPTH OF COMPLETED WELL: <u>52</u> ft. ELEVATION:
--	---

Depth(s) Groundwater Encountered 1. 21 ft. 2. ft. 3. ft.WELL'S STATIC WATER LEVEL 21 ft. below land surface measured on mo/day/yr AUG-8-88

Pump test data: Well water was ft. after hours pumping gpm

Est. Yield 35 gpm: Well water was ft. after hours pumping gpmBore Hole Diameter 10 in. to 52 ft., and in. to ft.

WELL WATER TO BE USED AS:

1 Domestic 3 Feedlot 6 Oil field water supply 9 Dewatering 12 Other (Specify below)

2 Irrigation 4 Industrial 7 Lawn and garden only 10 Observation well

Was a chemical/bacteriological sample submitted to Department? Yes No; If yes, mo/day/yr sample was submittedWater Well Disinfected? Yes No

5 TYPE OF BLANK CASING USED:	5 Wrought iron	8 Concrete tile	CASING JOINTS: <u>Glued</u> Clamped
------------------------------	----------------	-----------------	-------------------------------------

1 Steel 3 RMP (SR) 6 Asbestos-Cement 9 Other (specify below) Welded

2 PVC 4 ABS 7 Fiberglass Threaded

Blank casing diameter 5 in. to 32 ft., Dia in. to ft.Casing height above land surface 12 in., weight lbs./ft. Wall thickness or gauge No.

TYPE OF SCREEN OR PERFORATION MATERIAL:

1 Steel 3 Stainless steel 5 Fiberglass 8 RMP (SR) 11 Other (specify)

2 Brass 4 Galvanized steel 6 Concrete tile 9 ABS 12 None used (open hole)

SCREEN OR PERFORATION OPENINGS ARE:

1 Continuous slot 3 Mill slot 5 Gauzed wrapped 8 Saw cut 11 None (open hole)

2 Louvered shutter 4 Key punched 6 Wire wrapped 9 Drilled holes

SCREEN-PERFORATED INTERVALS: From 32 ft. to 52 ft., From ft. to ft.From 27 ft. to 32 ft., From ft. to ft.

GRAVEL PACK INTERVALS: From ft. to ft., From ft. to ft.

From ft. to ft., From ft. to ft.

FROM TO LITHOLOGIC LOG

FROM TO LITHOLOGIC LOG

6 GROUT MATERIAL: 1 Neat cement 2 Cement grout 3 Bentonite 4 Other ft., From ft. to ft.

Grout Intervals: From 0 ft. to 27 ft., From ft. to ft.

What is the nearest source of possible contamination:

1 Septic tank 4 Lateral lines 7 Pit privy 11 Fuel storage 15 Oil well/Gas well

2 Sewer lines 5 Cess pool 8 Sewage lagoon 12 Fertilizer storage 16 Other (specify below)

3 Watertight sewer lines 6 Seepage pit 9 Feedyard 13 Insecticide storage UNKNOWN

Direction from well? How many feet?

FROM TO LITHOLOGIC LOG

FROM TO LITHOLOGIC LOG

